

U.S. PUBLIC LAND SURVEY MONUMENT RECORD

For Public Land Survey Corners in: T. 1 N., R. 10 E 4th P.M.
CORNER CODE INDEX

WI ADMINISTRATIVE CODE A-E 7.08 REQUIREMENT

	2	3	4	5	6	7	8	9	10	11	12	13	14	15	16	17	18	19	20	21	22	23	24	25
A																								
B	6																							
C		5																						
D			4																					
E				3																				
F					2																			
G						1																		
H	7																							
I		8																						
J			9																					
K				10																				
L					11																			
M						12																		
N							13																	
O								14																
P									15															
Q										16														
R											17													
S												18												
T													19											
U														20										
V															21									
W																22								
X																	23							
Y																		24						
Z																			25					

Avon TWP
ROCK COUNTY, WI

IF AVAILABLE
ROCK COUNTY COORDINATES PREFERRED

North 204057, 278' Elev. 936.8'
 East 2155189, 394
 Hor. Datum 83/91 Vert. Datum 29
 LATITUDE _____ ELLIPS. HT. _____
 LONGITUDE _____ ELLIPS. DATUM _____
 NAD83(91) COUNTY _____ LIST _____
 GPS (X) TRAVERSE (X) _____
 BASED ON THE FOLLOWING CONTROL:

PLACE MONUMENT SYMBOL \blacklozenge AT PROPER LOCATION ON ABOVE INDEX

\blacklozenge CORNER MONUMENT

\circ WITNESS MONUMENT

(a)

Aluminum monument
with broken cap found

1" x 24" iron pipe set

Note: Aluminum Monument 175' south of
c/L S.T.H. "181" \pm 4' east of c/L of
S. Nelson Rd.

RM = 1" x 24" iron pipe set


RM 1) set 48' north of mon.,
 \pm 6' east of edge of pvmt. in
line with power poles
N16°E 49.50'

RM 2) set 30' south on mon., \pm 6' east
of edge of pvmt.
S26°W 31.35'

RM 3) set 30' south of mon., \pm 6' east
of edge of pavement.
S36°W 34.52'

RM 4) set 52' north of mon., \pm 6' west of
edge of pvmt.; in line with
power poles
N22°W 58.38'

BEARINGS ARE BASED ON:

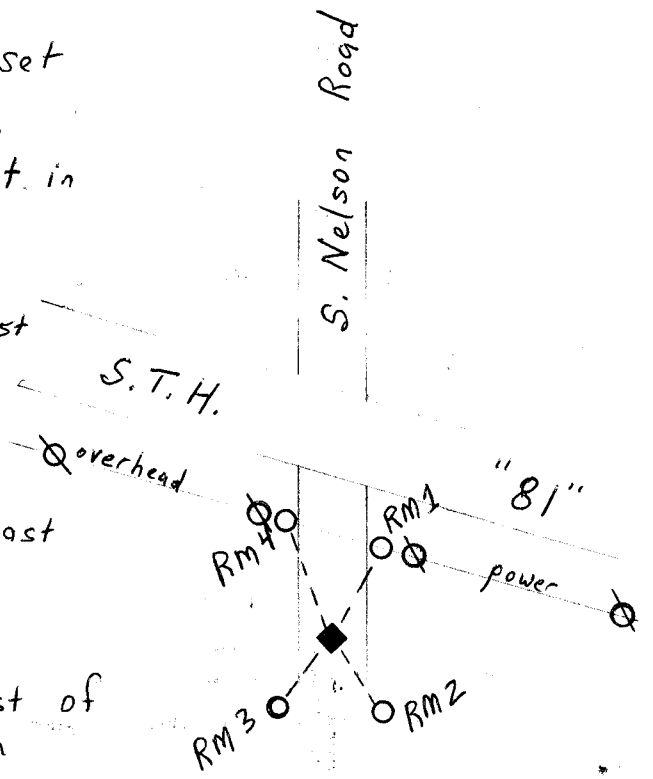

FIELD BOOK P-292 PAGE # 7

SHEET _____ OF _____

SHOW A PLAN VIEW DRAWING DEPICTING THE CORNER MONUMENT AND SURROUNDING PHYSICAL FEATURES, INCLUDING THE EXCAVATION AREA AND DEPTH.

PLANNING & ZONING COMMITTEE ADOPTED THE ABOVE FORM ON 12/2/1982

CORNER CODE J-13(1)

B) Describe any record evidence, monument evidence, occupational evidence, testimonial evidence or any other material evidence you considered, and whether the monument was found or placed.

Aluminum Monument found. Said monument was used for previous surveys. See Certified Survey Map Document No. 873819, Vol. 7, pg. 65 & Map #14793 in the Rock Co. Surveyor's office.

C) Was the corner restored through acceptance of (1) an obliterated evidence location, or, (2) a found perpetuated location?

D) Describe any material discrepancy between the location of the Corner as restored or reestablished and the location of that corner as previously restored or reestablished by distance and direction. Show the discrepancy on the plan view drawing under (a), above. Show the distances between the corner as previously restored or reestablished and (1) the corner as restored or reestablished, and (2) to at least 4 of the witness monuments shown on the drawing in (a), above.

E) Was the corner reestablished through lost corner proportionate methods? If so, show the method, including the directions and distances to other public land survey corners used as evidence or used for proportioning the corner location.

I, Anthony P. Lulloff, hereby certify that the corner location as identified by the corner code index was determined by me under by direction and control and that this U.S. Public Land Survey Monument Record is correct and complete to the best of my knowledge and belief.

seal

emboss/stamped



Anthony P. Lulloff
1/5/04

Number of included sheets _____