
U.S. PUBLIC LAND SURVEY MONUMENT RECORD

For Public Land Survey Corners in the

LIMA T. 4 N., R. 14 E.

CORNER CODE INDEX

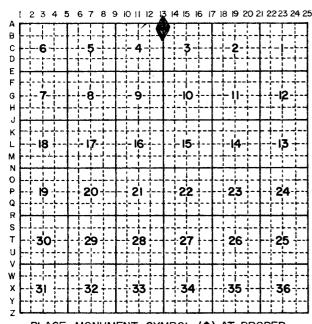

PLACE MONUMENT SYMBOL (*) AT PROPER LOCATION ON ABOVE INDEX

IF AVAILABLE STATE PLANE COORDINATES


North (Y) 30977536 Eleve. (Z) 870

East (X**2**,312,04/.)/ Zone **South**


Hor. Datum _____ Vert. Datum


For Miscellaneous Corners within Sec.

3,T._4_N., R.__/4_E.

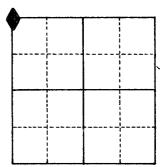

- Above code numbers are positioned Meander, Claim, or Fractional corners of the section.
- 2. Township corner code numbers shall be applied to the corners of above typical section.

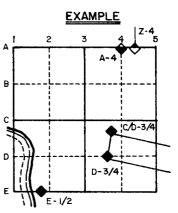

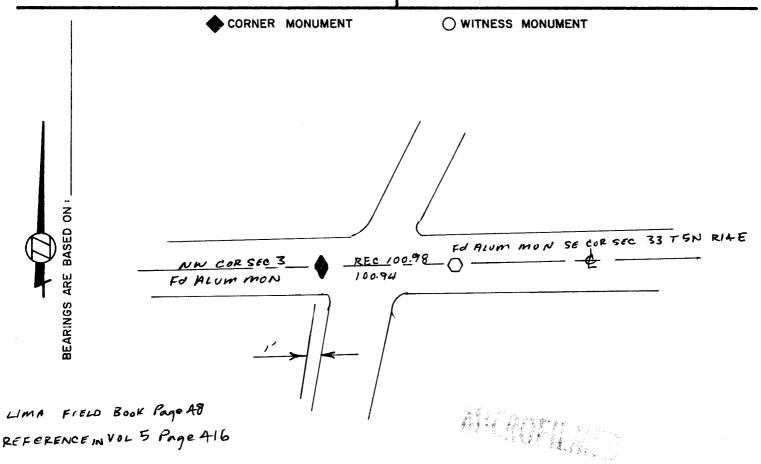

SHOW A PLAN VIEW DRAWING DEPICTING THE CORNER MONUMENT AND SURROUNDING PHYSICAL FEATURES, INCLUDING THE EXCAVATION AREA AND DEPTH. THE CORNER MONUMENT SHALL HAVE THE FOLLOWING CHARACTERISTICS: I) HAVE AT LEAST TWO PREDETERMINED BREAK-OFF POINTS. 2) IF BROKEN, LEAVE A PERMANENTLY MAGNETIZED REMNANT AT THE ORIGINAL POINT. 3) MUST BE EXTENDABLE. 4) THE CAP IS INSCRIBED: ROCK COUNTY SURVEY MONUMENT - PENALTY FOR DISTURBING MARKER. 5) OR AN EXISTING CUT LIMESTONE. AN IRON PIPE I 1/2 " x 4'0" (MINIMUM) WITH AT LEAST 4 DURABLE WITNESS MONUMENTS MAY BE USED IN AREAS WHERE GROUND WATER IS WITHIN 1.0' OF THE SURFACE. IF THE CORNER IS OCCUPIED BY AN IMPROVEMENT (MANHOLE, BURIED CABLE, ETC.), ANY DURABLE, DISTINCT MONUMENT MAY BE USED AND REFERENCED WITH AT LEAST 4 DURABLE WITNESS MONUMENTS.

FOUND MONUMENT OF RECORD	
	repancy between the location of the
corner as restored of re-estored corner as previously restored	stablished and the location of that sed or re-established.
Was the corner restored the	ough acceptance of an obliterated
evidence location or a four	
ACCEPTED FOUND PERPETUATED LO	OCATION
	ned through lost corner proportionate
methods? If so, show the m distances to other public l	nethod, including directions and and and and survey corners used as evidence
methods? If so, show the m distances to other public l or used for proportioning i	nethod, including directions and
methods? If so, show the m distances to other public l	nethod, including directions and and and and survey corners used as evidence
methods? If so, show the m distances to other public l or used for proportioning i	nethod, including directions and and and and survey corners used as evidence
methods? If so, show the m distances to other public l or used for proportioning i	nethod, including directions and and and and survey corners used as evidence
methods? If so, show the m distances to other public l or used for proportioning i NO I, Dando Banes,	nethod, including directions and and survey corners used as evidence in determination of the corner location. The corner points in the corner points in the corner points in the corner points in the corner points.
methods? If so, show the m distances to other public l or used for proportioning i NO I, Danle Banes, as identified by the corner	hereby certify that the corner points code index were, in a field survey on
methods? If so, show the m distances to other public l or used for proportioning in NO I, Dandbaues, as identified by the corner Tune 1982, established	hethod, including directions and and survey corners used as evidence in determination of the corner location. Thereby certify that the corner points code index were, in a field survey on the corner includes the corner points of the corner points code index were, in a field survey on the corner points and the corner points code index were, in a field survey on the corner points that the corner points code index were, in a field survey on the corner points that the corner points code index were, in a field survey on the corner points that the corner points code index were, in a field survey on the corner points that the corner points code index were, in a field survey on the corner points that the corner points code index were, in a field survey on the corner points that the corner points code index were, in a field survey on the corner points that the corner points code index were, in a field survey on the corner points that the corner points code index were, in a field survey on the corner points that the corner points code index were, in a field survey on the corner points that the corner points code index were, in a field survey on the corner points that the corner points code index were.
If so, show the magnetic distances to other public land or used for proportioning in the second of t	hereby certify that the corner points code index were, in a field survey on re-established, monumented, re-monume pressed below and in conformance with tequired in the current manual of survey
If so, show the maistances to other public lor used for proportioning in the second se	hereby certify that the corner points code index were, in a field survey on the corner points code index were, in a field survey on the corner below that the corner points code index were in a field survey on the corner points code index were in a field survey on the corner points code index were in a field survey on the corner points code index were in a field survey on the corner points code index were in a field survey on the corner points code index were in a field survey on the corner points code index were in a field survey on the corner points code index were in a field survey on the corner points code index were in a field survey on the corner points code index were in a field survey on the corner points code index were in a field survey on the corner points code index a field survey of the code index were in a field survey of the code index were in a field survey of the code index were in a field survey of the code index were in a field survey of the code index were in a field survey of the code index were in a field survey of the code index were in a field survey of the code index were in a field survey of the code index were in a field survey of the code index were in a field survey of the code index were in a fiel
If so, show the magnetic distances to other public land or used for proportioning in the second of t	hereby certify that the corner points code index were, in a field survey on re-established, monumented, re-monume pressed below and in conformance with tequired in the current manual of survey States Department of Interior, Bureau
If so, show the maistances to other public lor used for proportioning in the second se	hereby certify that the corner points code index were, in a field survey on re-established, monumented, re-monume pressed below and in conformance with tequired in the current manual of survey
If so, show the maistances to other public lor used for proportioning in the second se	hereby certify that the corner points code index were, in a field survey on re-established, monumented, re-monume pressed below and in conformance with t quired in the current manual of survey States Department of Interior, Bureau COUNTY SURVEYOR FILING DATA Date of Computer Entry
If so, show the maistances to other public lor used for proportioning in the second se	hereby certify that the corner points code index were, in a field survey on re-established, monumented, re-monume pressed below and in conformance with toquired in the current manual of survey States Department of Interior, Bureau COUNTY SURVEYOR FILING DATA Date of Computer Entry Date Received
If so, show the maistances to other public lor used for proportioning in the solution of the loss of the United distances. If so, show the maistances to other public loss of the United distances. If so, show the maistance is a solution of the united distances. If so, show the maistance is a solution of the united distances. If so, show the maistance is a solution of the united distances. If so, show the maistance is a solution of the united in the united distances. If so, show the maistance is a solution of the united distances. If so, show the maistances is a solution of the united distances. If so, show the maistances is a solution of the united distances. If so, show the maistances is a solution of the united distances in the solution of the united distances.	hereby certify that the corner points code index were, in a field survey on re-established, monumented, re-monume pressed below and in conformance with the current manual of survey States Department of Interior, Bureau COUNTY SURVEYOR FILING DATA Date of Computer Entry Date Received Date Microfilmed
If so, show the maistances to other public lor used for proportioning in the second se	hereby certify that the corner points code index were, in a field survey on re-established, monumented, re-monume pressed below and in conformance with toquired in the current manual of survey States Department of Interior, Bureau COUNTY SURVEYOR FILING DATA Date of Computer Entry Date Received Date Microfilmed Date No.
If so, show the maistances to other public lor used for proportioning in the solution of the loss of the United distances. If so, show the maistances to other public loss of the United distances. If so, show the maistance is a solution of the united distances. If so, show the maistance is a solution of the united distances. If so, show the maistance is a solution of the united distances. If so, show the maistance is a solution of the united in the united distances. If so, show the maistance is a solution of the united distances. If so, show the maistances is a solution of the united distances. If so, show the maistances is a solution of the united distances. If so, show the maistances is a solution of the united distances in the solution of the united distances.	hereby certify that the corner points code index were, in a field survey on re-established, monumented, re-monume pressed below and in conformance with the current manual of survey States Department of Interior, Bureau COUNTY SURVEYOR FILING DATA Date of Computer Entry Date Received Date Microfilmed