

PLAT AND RECORD

417
VOL. 5

Of a Survey on Section 36 T 1 R 13 E. of the 4 P. M. in TURTLE Township
Rock County, Wisconsin, made APRIL the 28 19 78

I hereby certify that the following is a correct record of said survey as made by me.

COUNTY BUILDING
CITY OF JANESVILLE

Donald Barnes



County Surveyor.


SW CORNER OF SECTION 36

SHONSTEDT METAL DETECTOR LOCATED SOMETHING WITH
A STRONG SIGNAL. REFERENCED SAME & ONCE ASPHALT

WAS REMOVED THE SOURCE WAS REMOVED. FOUND CLUSTER
OF SMALL LIMESTONES 1' DEEP. DUG 4' TO OLD ROAD BED.
MR H,LEE STATED HE HAD A PLAT OF SURVEY BY C. SHIMEAL
WHICH STATED HE HAD SET A R/R SPIKE, ACCEPTED LOCATION
AS CORNER THAT C SHIMEALL SET.

VOID

MICROFILMED

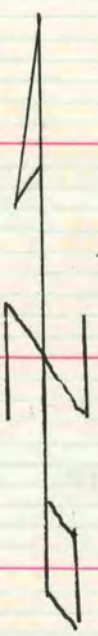

STATELINE RD