

MICROFILMED PLAT AND RECORD


Of a Survey on Section 11 T 2 R 12 E. of the 4 P. M. in Rock Township

Rock County, Wisconsin, made April the 28th 1880

I hereby certify that the following is a correct record of said survey as made by me.

COUNTY BUILDING
CITY OF JANESVILLE

(Signed) R. K. Lee Dept.
R.H.B. County Surveyor.

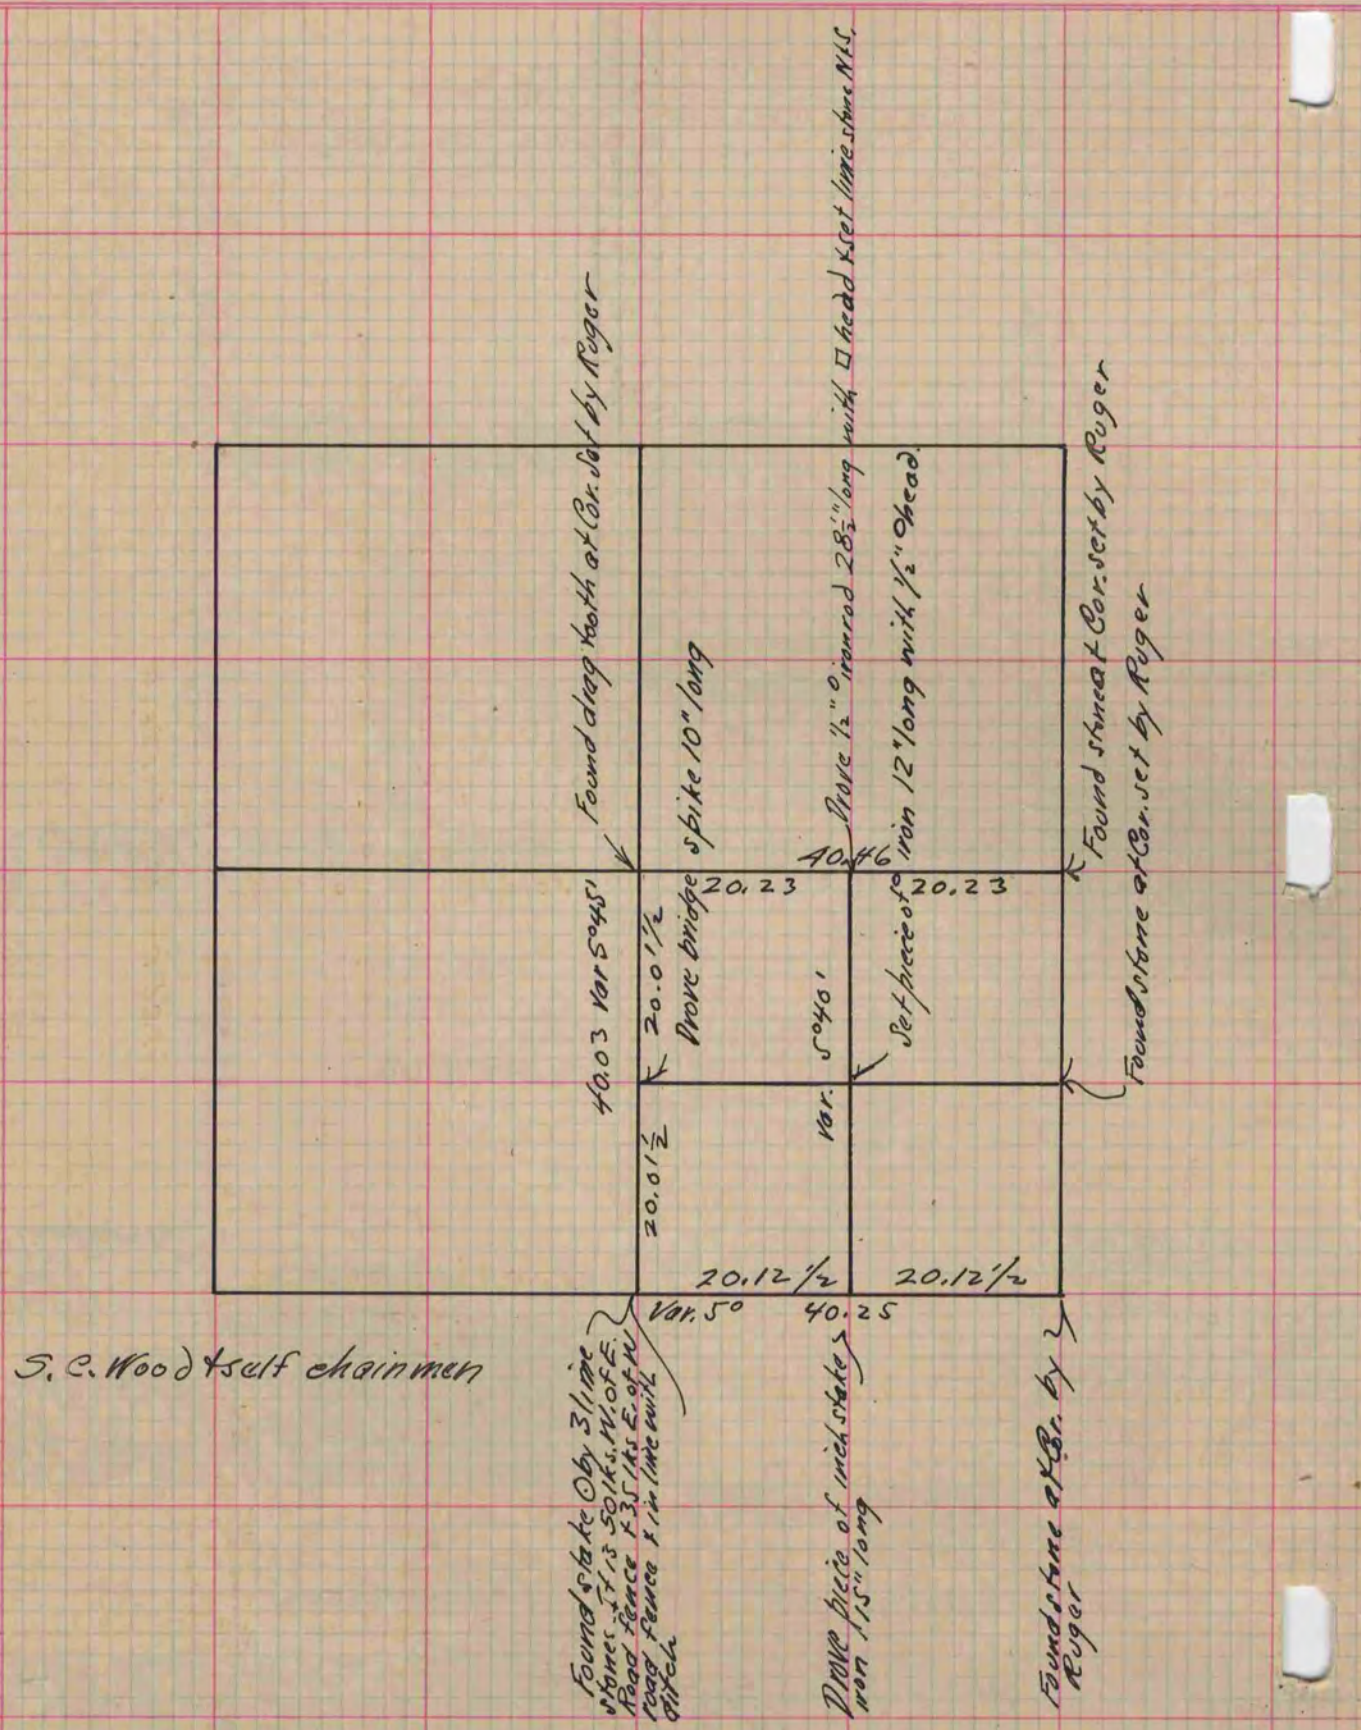

Copied from page 250 Vol. 2. County Surveyors Record.