

# PLAT AND RECORD

291  
V-2

**MICROFILMED**


COUNTY BUILDING  
CITY OF JANESVILLE

Of a Survey on Section 18 T 3 R 13 E. of the 4 P. M. in Harmony Township

Rock County, Wisconsin, made April the 13 1885

I hereby certify that the following is a correct record of said survey as made by me.

(Signed) Edward Ruger  
R.H.B. County Surveyor.

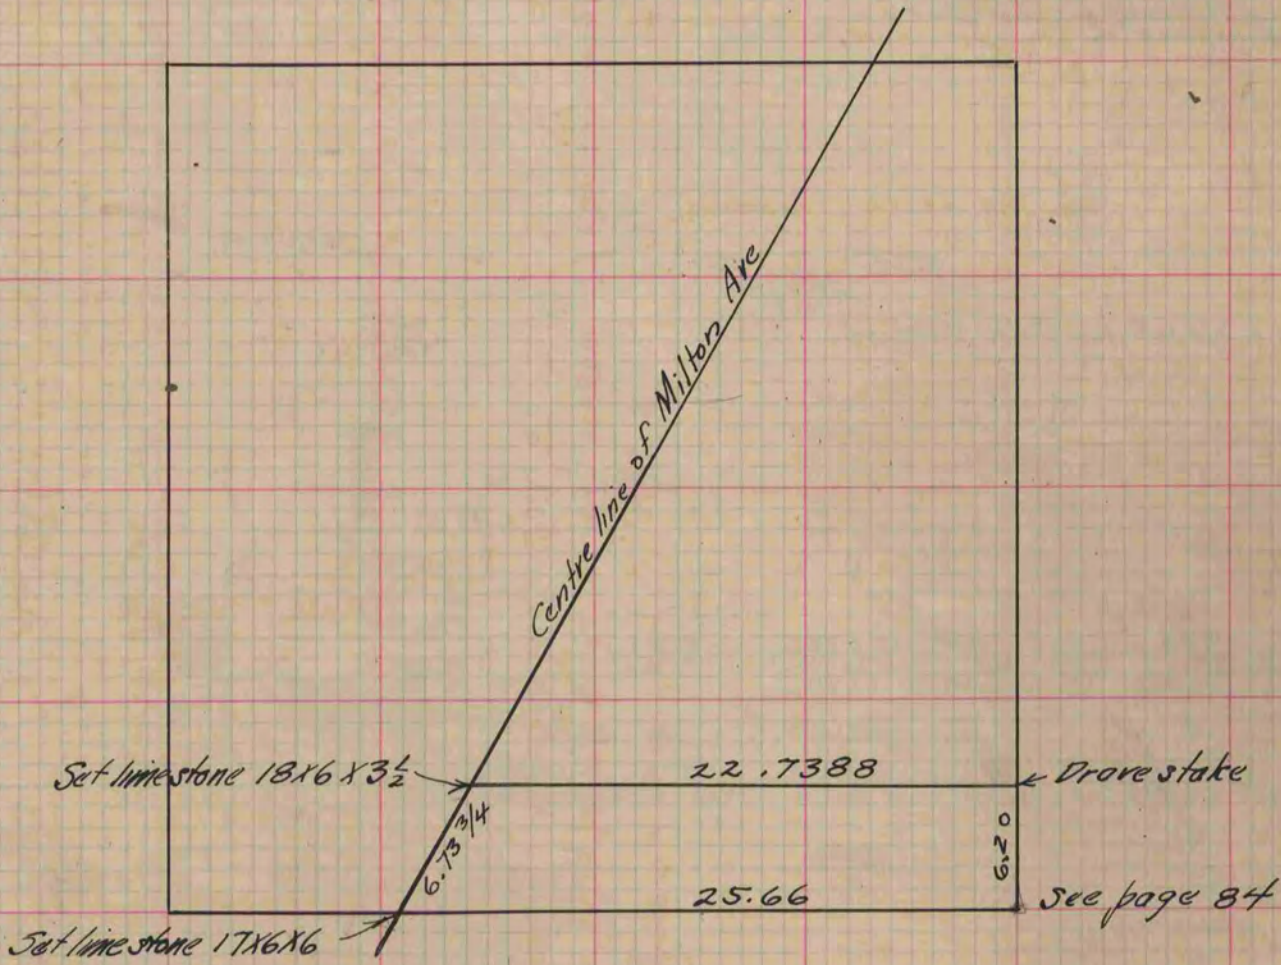

Copied from Page 243 Vol. 2. County Surveyors Record.