

PLAT AND RECORD

457


COUNTY BUILDING
CITY OF JANESVILLE

VOL. 5

Of a Survey on Section 12 T. 2 R. 12 E. of the 4 P. M. in ROCK Township

Rock County, Wisconsin, made JULY the 14 19 78



I hereby certify that the following is a correct record of said survey as made by me.

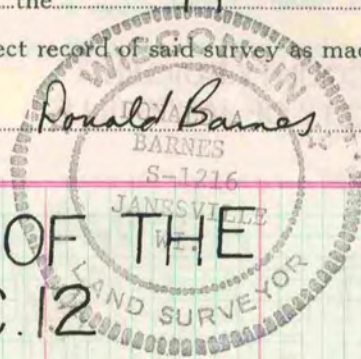

County Surveyor.

W 1/16 COR. OF THE SW 1/4 SE C. 12

FOUND DRAG TOOTH.

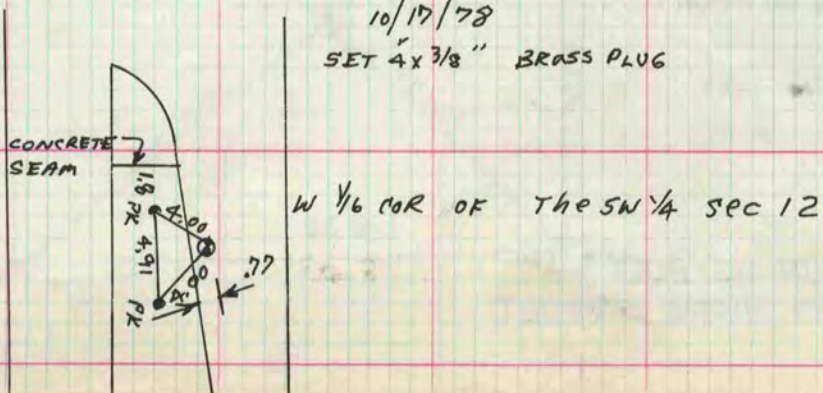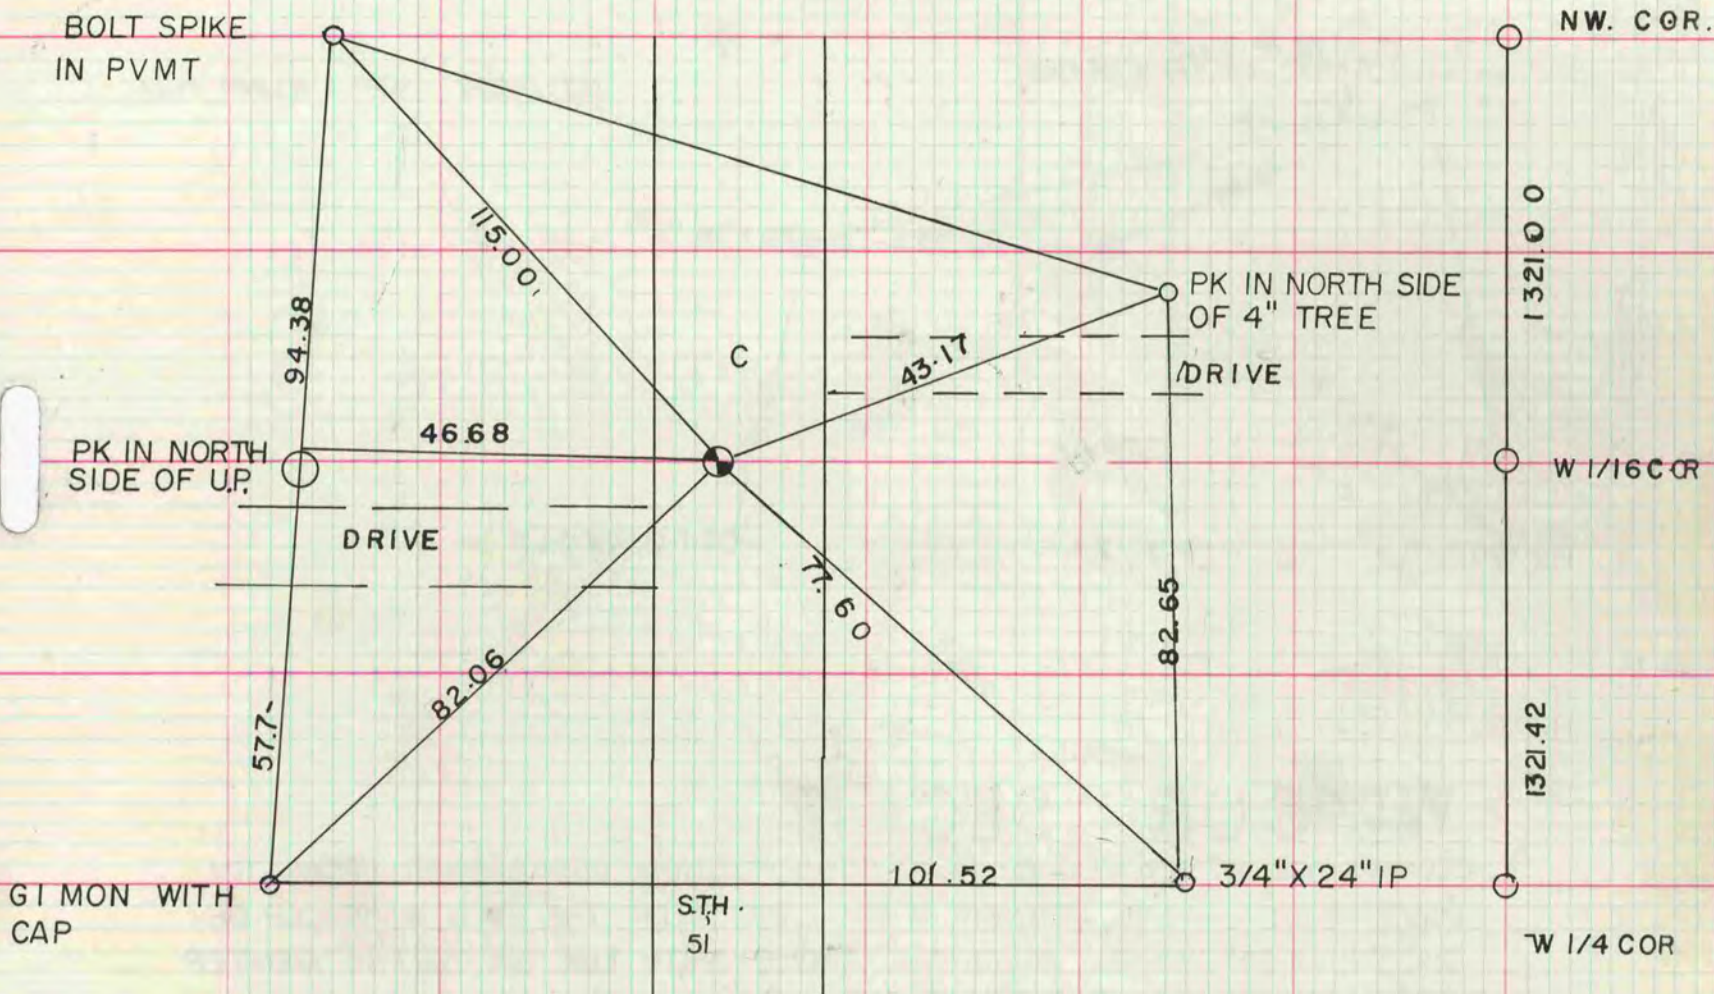

MICROFILMED