

Of a Survey on Section 34 T. 2 R. 12 E. of the 4 P. M. in LIMA ROCK Township  
Rock County, Wisconsin, made OCT 2 1978

I hereby certify that the following is a correct record of said survey as made by me.

COUN. JING  
CITY OF JANESVILLE



N 1/4 COR SEC 20 ROCK

FOUND ALUM MON


TWP



SEC 34 LIMA TWP

INFORMATION SUPPLIED BY H LEE SEE BI FILES

MICROFILMED

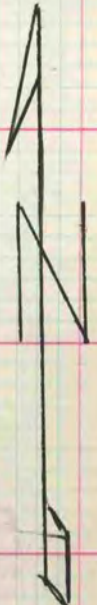

NW COR

S89°47'44"W 2671.264'

N 1/4 COR

S89°42'56"E 2666.189'

NE COR

ORDER NO 12063

N03°19'42"W 2644.43'  
N03°19'42"W 5288.867'

S89°56'54"E 2654.371'

N02°57'47"W 5296.555'

34

S89°47'37"E 2651.561'

N02°39'03"W 2643.886'

E 1/4 COR

SEC

CENTER

N02°39'03"W 2643.886'

WEST 2636.886'

93-05-26

2636.934' S89°52'21"E

87-13-18

SW COR

S 1/4 COR

SE COR