

# VOL. 5 PLAT AND RECORD

COUNTY BUILDING  
CITY OF JANESVILLE

Of a Survey on Section 17-18 T 3 R 12 E. of the 4 P. M. in JANESVILLE Township

Rock County, Wisconsin, made APRIL the 19 75

I hereby certify that the following is a correct record of said survey as made by me.

*Otto F. Schroeder*

County Surveyor.


**MICROFILMED**

R.P.'S ARE 1"X24" I.P.

4-17-75  
O.F.S.  
R.P.

FB 8/4

N.E. COR  
SEC 18-3-12

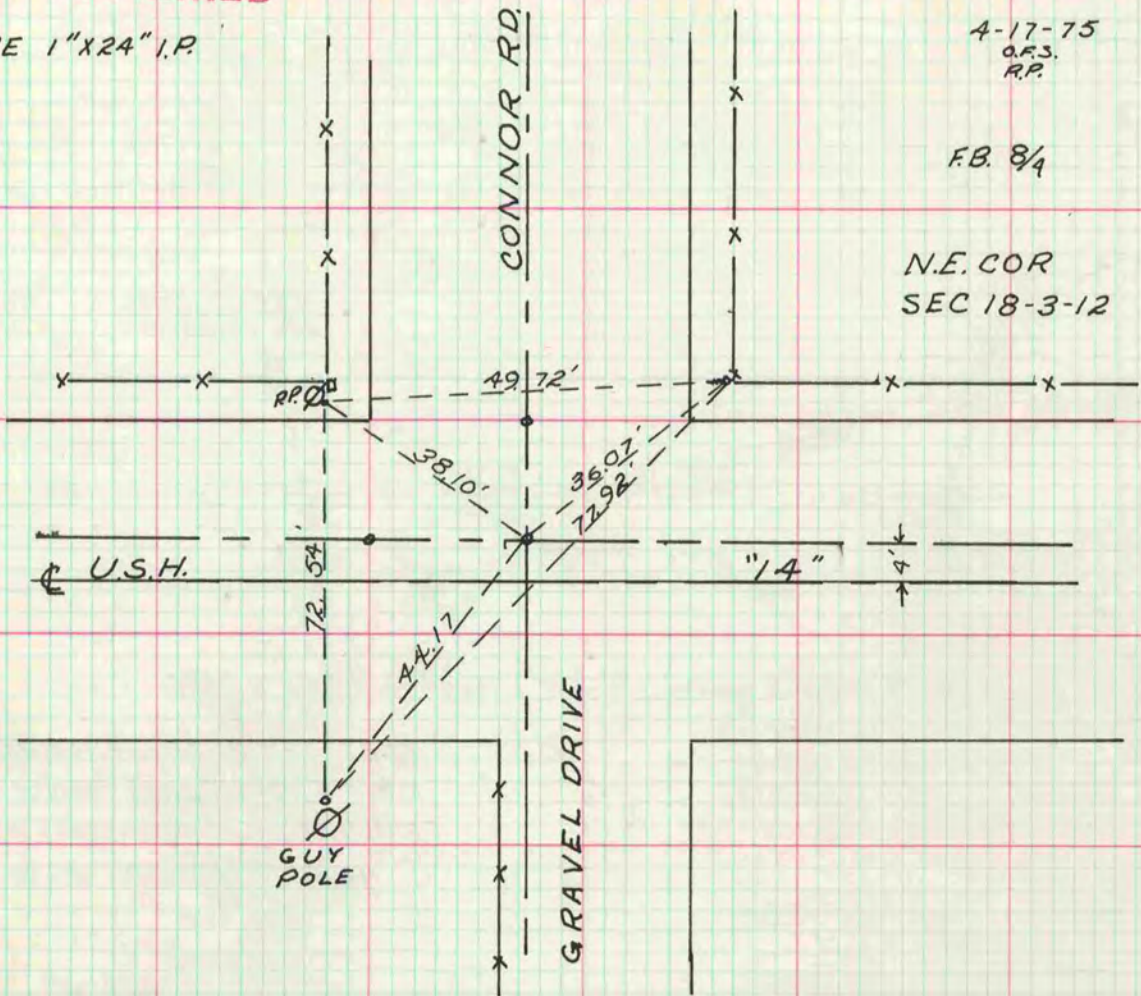

4-21-75  
O.F.S.  
R.P.

FB 8/4

ALL R.P.'S ARE  
1"X24" I.P.  
W.T.B. COR 8/17 3-12

