

# MICROFILMED PLAT AND RECORD

57  
V-I

Of a Survey on Section 10 T 2 R 10 E. of the 4 P. M. in Spring Valley Township  
Rock County, Wisconsin, made February the 12<sup>th</sup> 1856

I hereby certify that the following is a correct record of said survey as made by me.

COUNTY BUILDING  
CITY OF JANESVILLE

(Signed) Joseph Church  
R.H.B. County Surveyor.

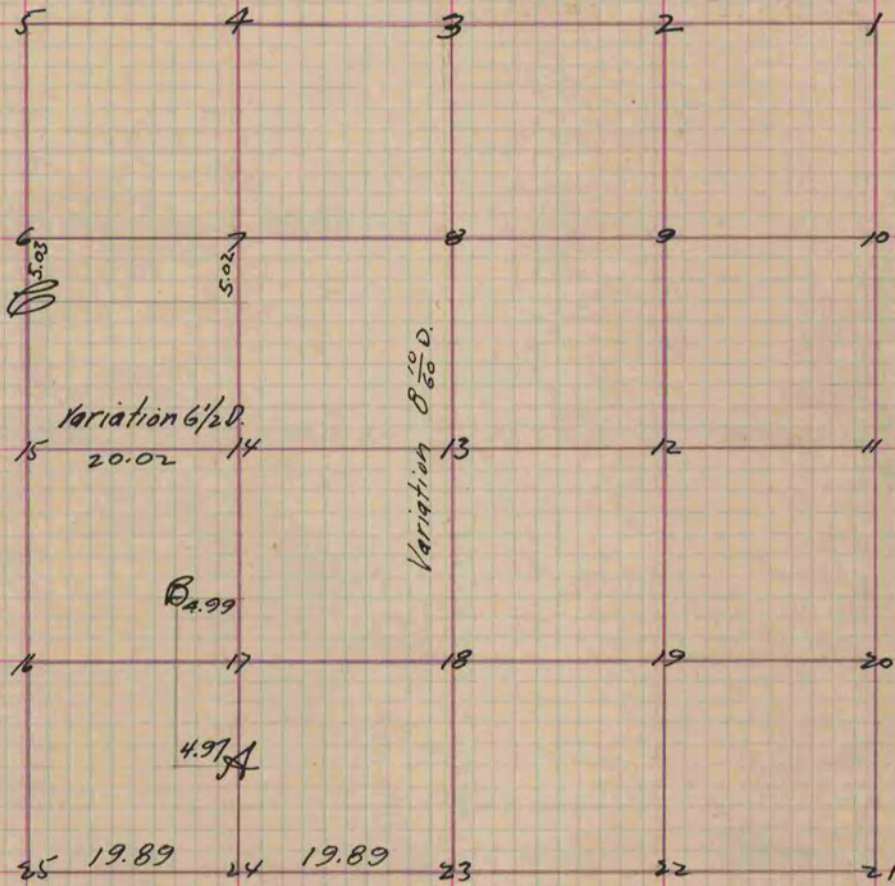


Fig 24 Br. O. 18 N 15 W. 75  
Letter A. Br. O. 14 S 88 W 34  
16 N 51 1/2 W 45  
B. Br. O. 18 N 73 W 120  
Br. O. 14 N 36 E 98  
C Br. O. 12 N 73 W. 57

Copied from Page 58 Vol. 1 Original County Surveyors Record