

# PLAT AND RECORD

**MICROFILMED**


Of a Survey on Section 4 T 4 R 12 E. of the 4 P. M. in Fulton Township

Rock County, Wisconsin, made December the 1- 1882

I hereby certify that the following is a correct record of said survey as made by me.

COUNTY BUILDING  
CITY OF JANESVILLE

(Signed) Edward Rugar  
R.H.B. County Surveyor.

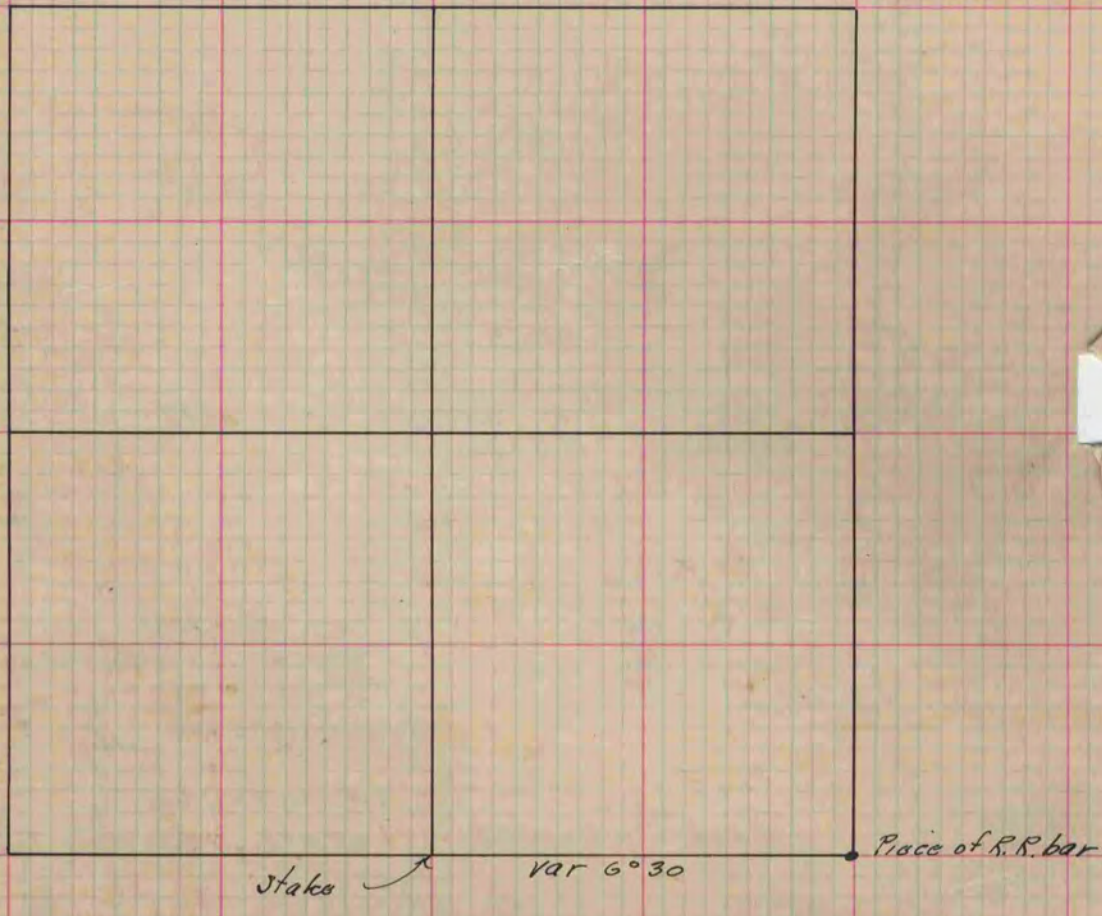

*Copied from P. 314 Vol. 2 County Surveyors Record.*