

PLAT AND RECORD

COUNTY BUILDING
CITY OF JANESVILLE

V-3 209
PG 201
BELOIT REC
12/15/75 DAB


MICROFILMED

Of a Survey on Section 34 & 35 T.3N R.12 E. of the 4 P. M. in JANESVILLE Township

Rock County, Wisconsin, made July the 6 to 27 1932

I hereby certify that the following is a correct record of said survey as made by me.

B. Bunny
County Surveyor.

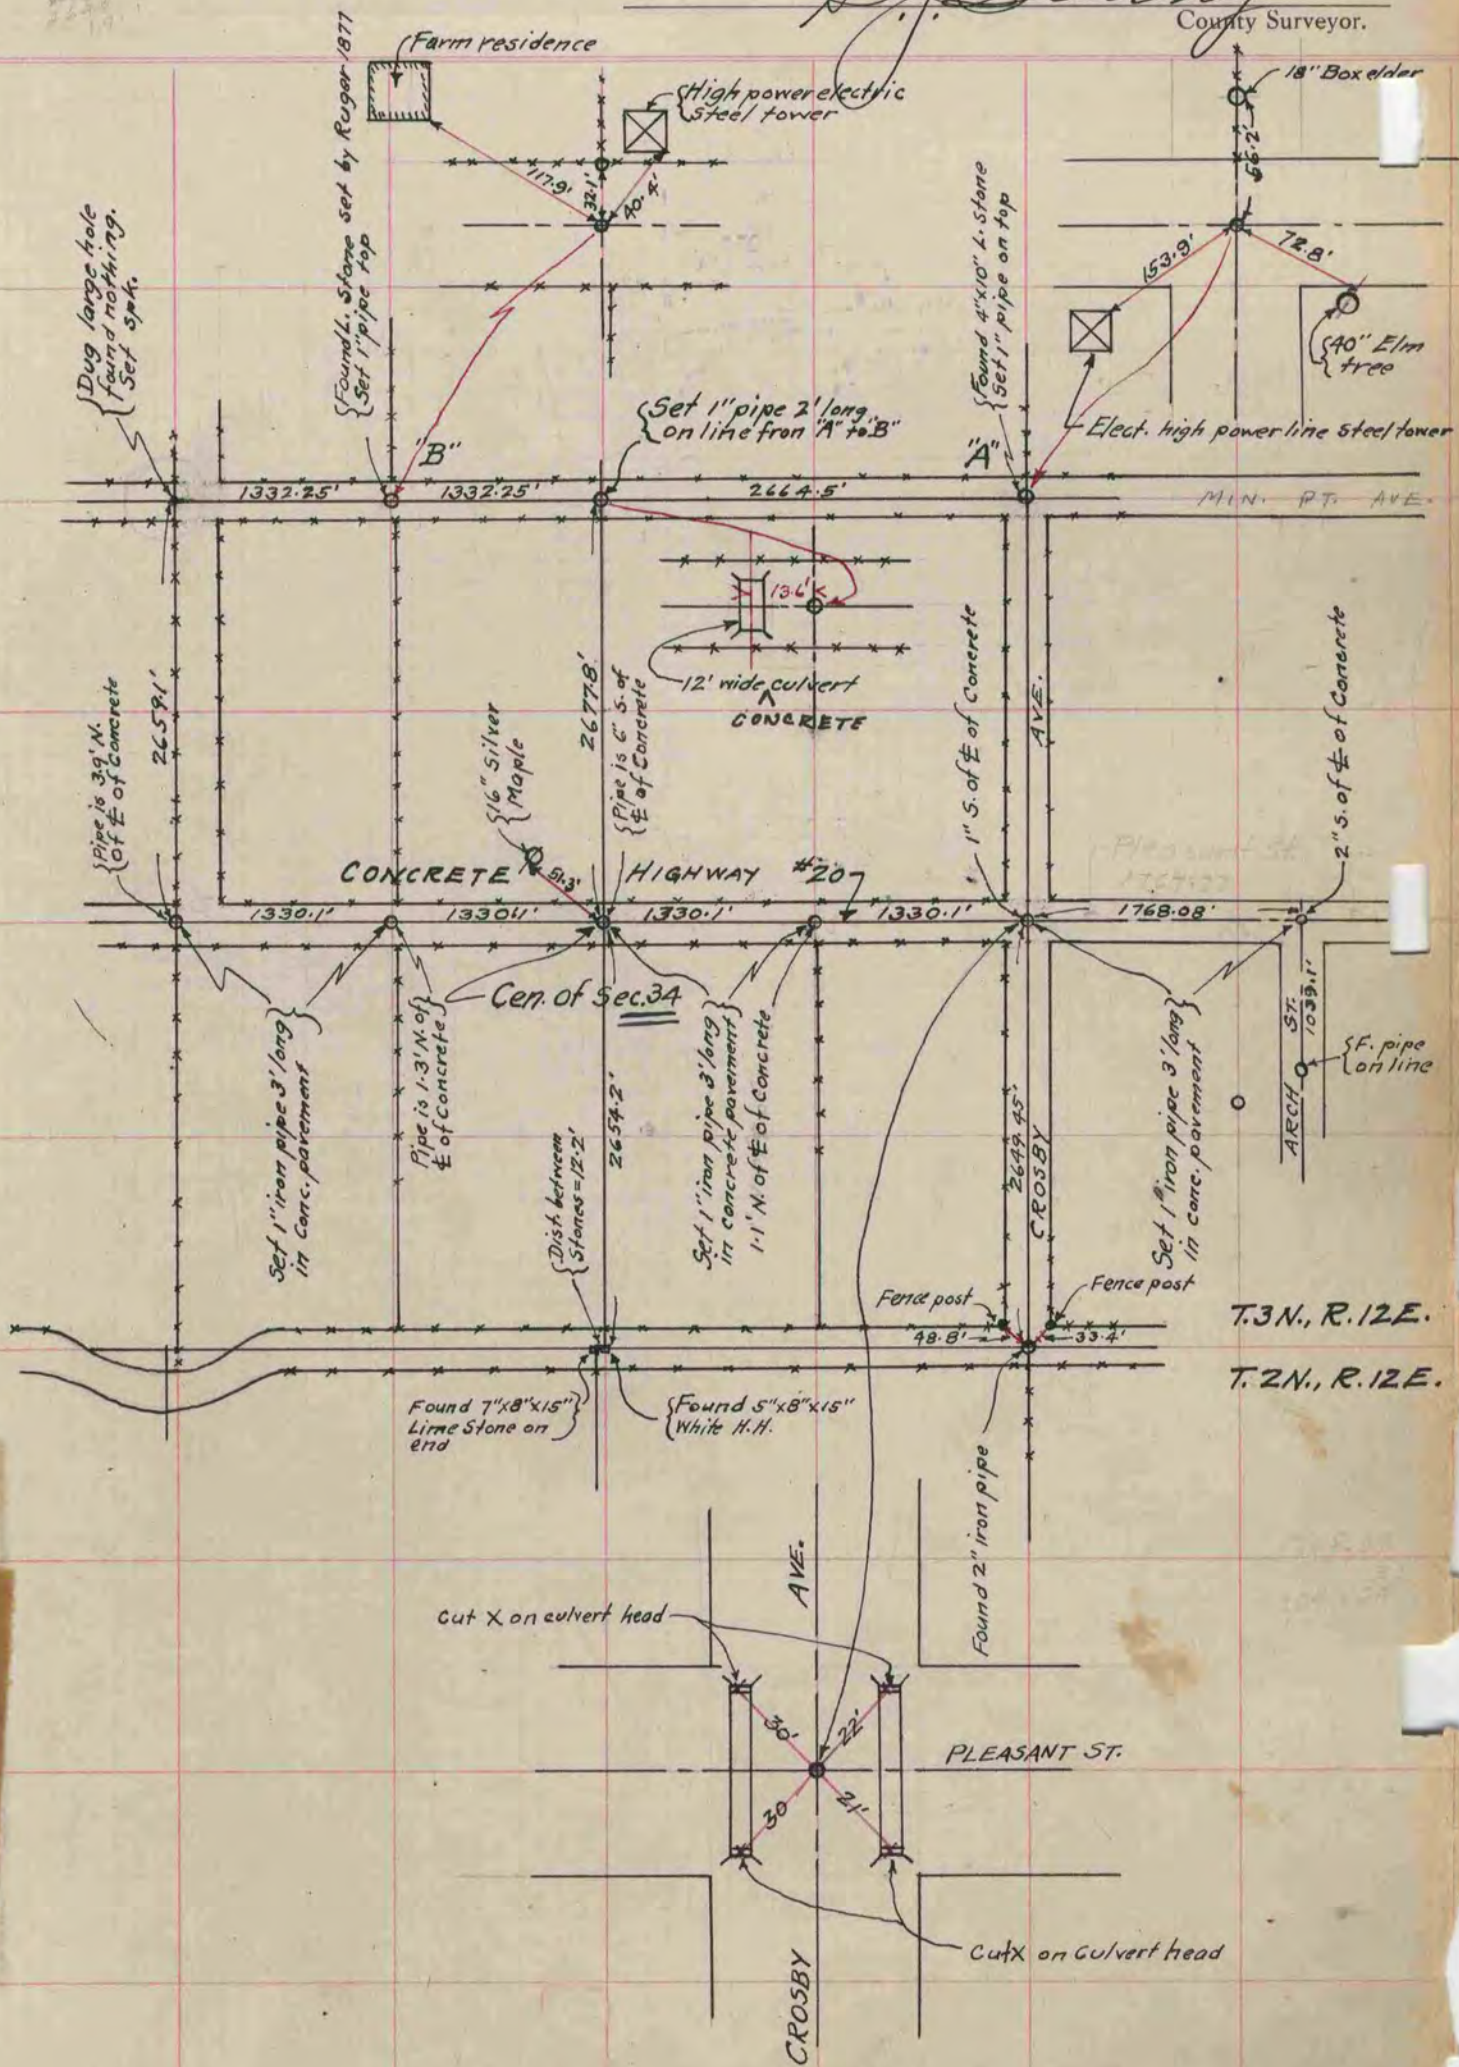

T.3N, R.12E.
T.2N, R.12E.