

PLAT AND RECORD

V-3
MICROFILMED

Of a Survey on Section 27 T 1 R 12 E. of the 4 P. M. in Beloit Township

Rock County, Wisconsin, made November the _____ 1919

I hereby certify that the following is a correct record of said survey as made by me.


COUNTY BUILDING
CITY OF JANESVILLE

A. A. Battersman

County Surveyor.

N 1/4 COR
9/22/1995
DAB

o = Gas pipe Monuments

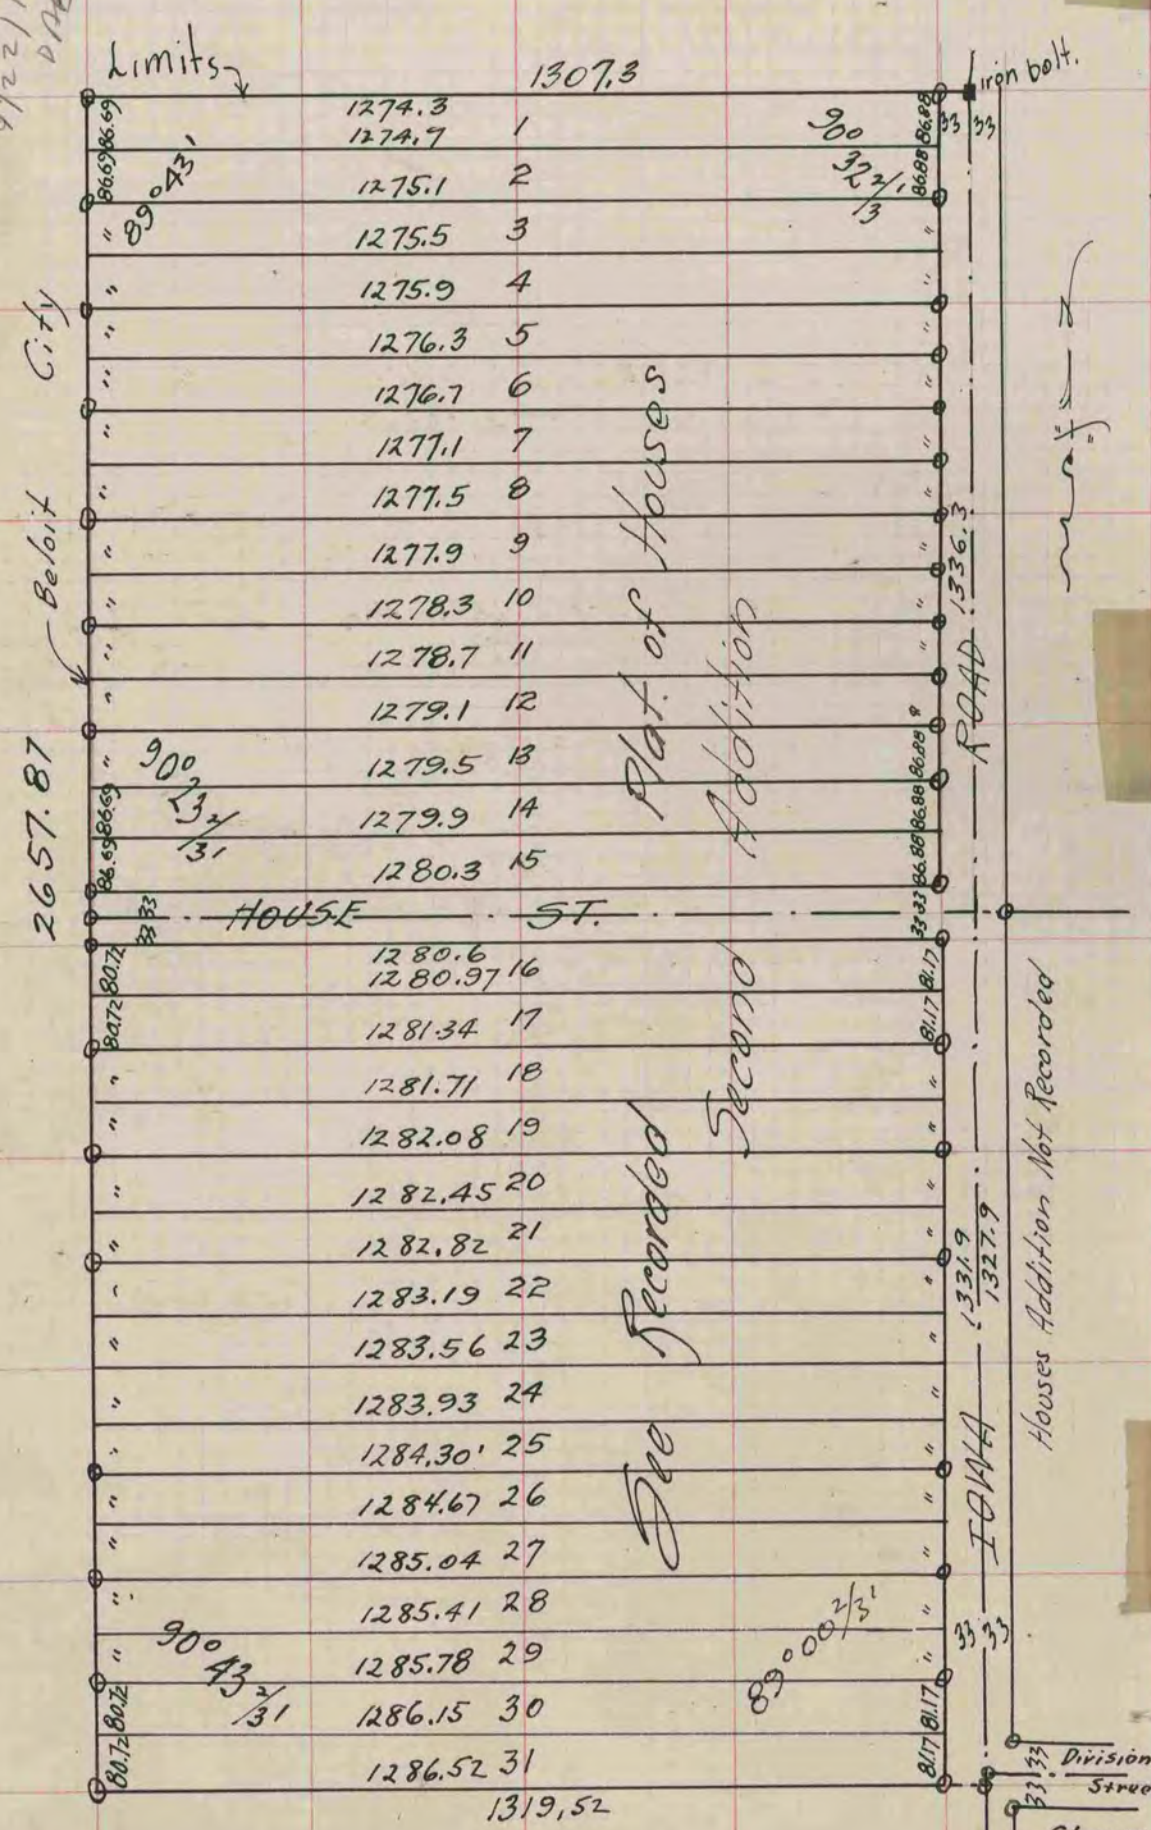

#290 For Sylvester House