

PLAT AND RECORD

COUNTY BUILDING
CITY OF JANESVILLE

Of a Survey on Section 35 T I R II E. of the 4 P. M. in NEWARK Township


Rock County, Wisconsin, made MAY the 21 1979

I hereby certify that the following is a correct record of said survey as made by me

Donald Barnes
County Surveyor.



SW COR SEC 35

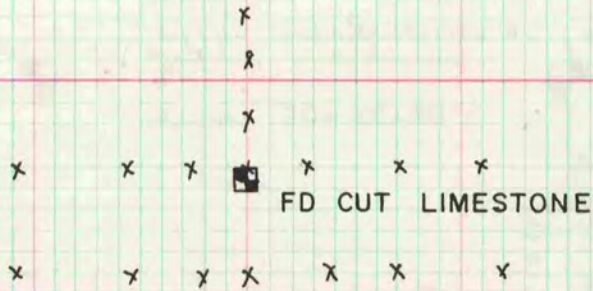

MICROFILMED

S 1/4 COR SEC 35

FOUND BOTTOM OF CUT LIMESTONE IN SW SIDE OF A 6" TREE,
REPLACED THE STONE WITH AN ALUM MON

