

MICROFILMED

# PLAT AND RECORD


355  
V-1

COUNTY BUILDING  
CITY OF JANESVILLE

Of a Survey on Section 2 T 3 R 11 E. of the 4 P. M. in Center Township  
Rock County, Wisconsin, made October the 8<sup>th</sup> to 10<sup>th</sup> 1869

I hereby certify that the following is a correct record of said survey as made by me.

(Signed) R. K. Lee  
R.H.B. Dep. County Surveyor.

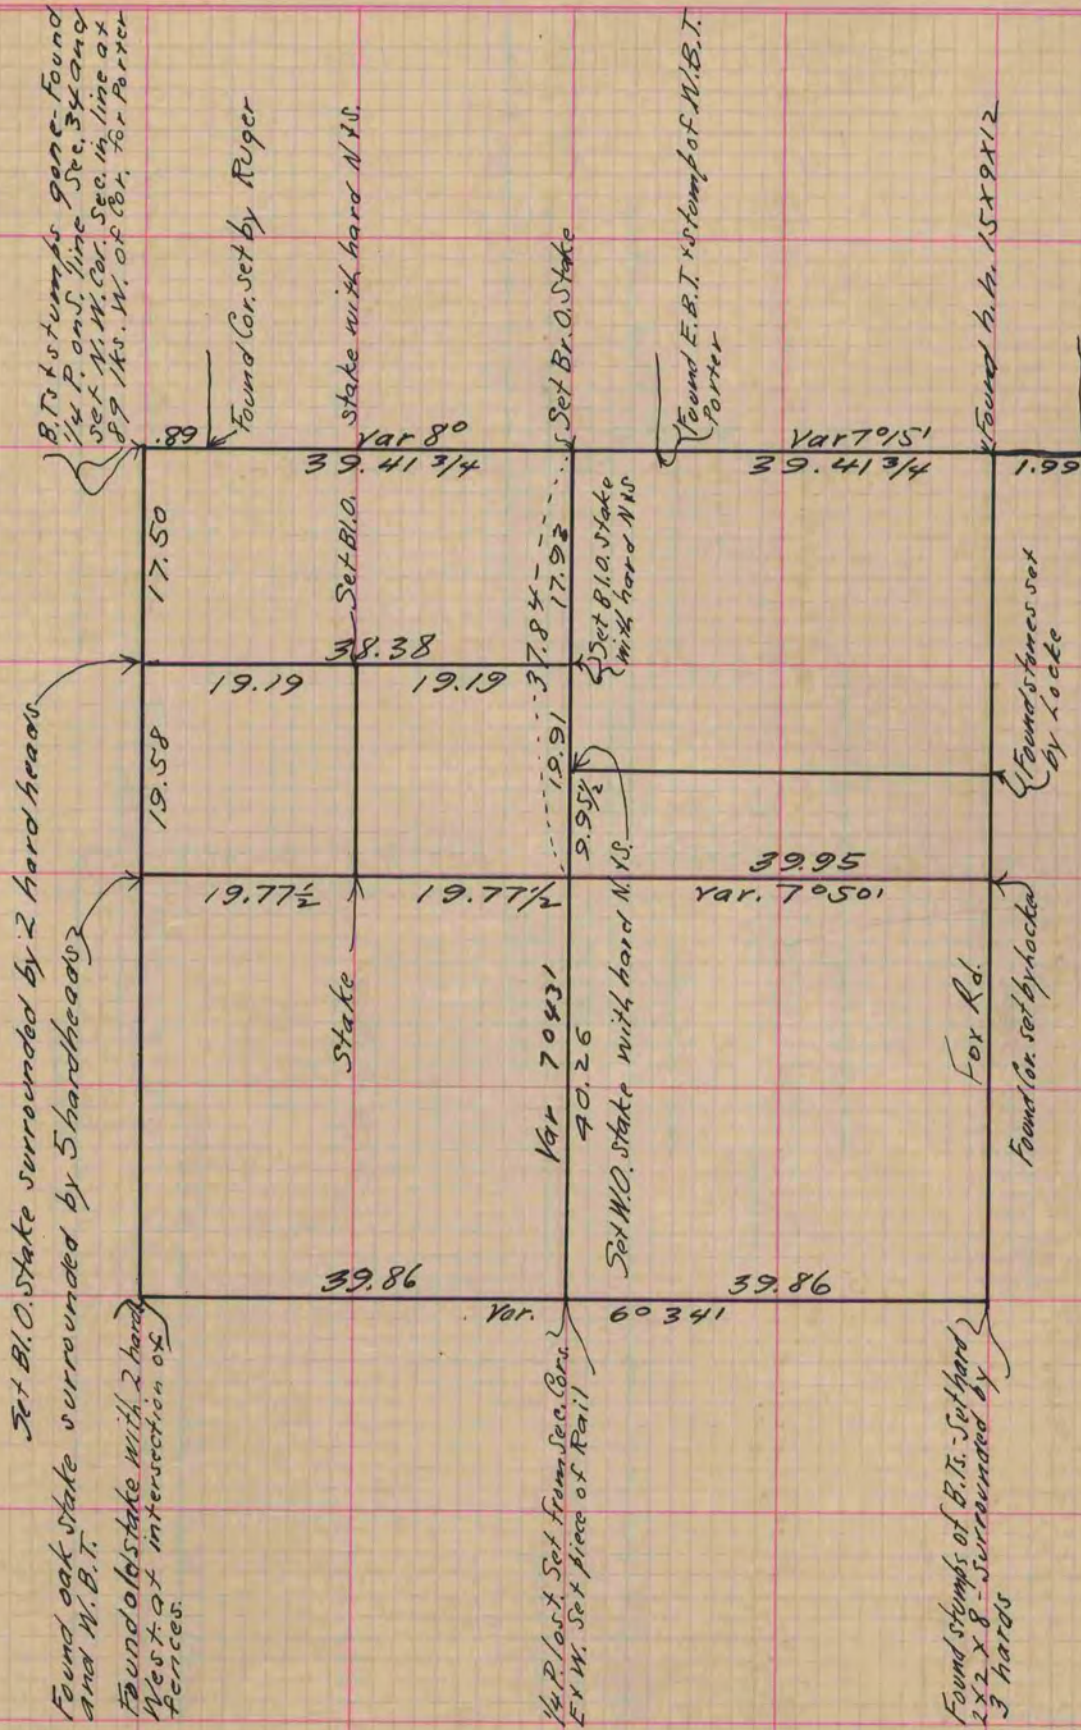

Copied from Page 285 Vol. 1. Original County Surveyors Record