


# PLAT AND RECORD

Of a Survey on Section 17, 18 T 4 R 10 E. of the 4 P. M. in UNION Township  
Rock County, Wisconsin, made APRIL the 30

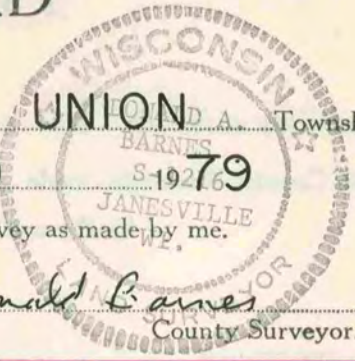


I hereby certify that the following is a correct record of said survey as made by me.

COUNTY BUILDING  
CITY OF JANESVILLE

Donald Barnes  
County Surveyor.

## NW COR SEC 17

FOUND CUT LIMESTONE @ 3 LARGE H H 0.5' DEEP

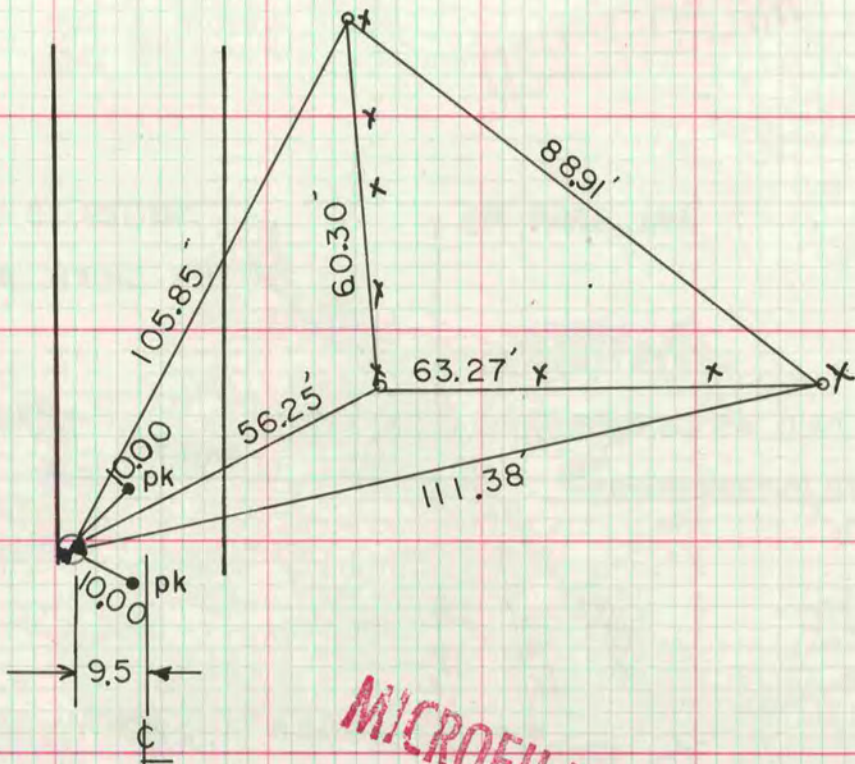

MICROFILMED

## N 1/4 COR SEC 18

DUG 3' DEEP & FOUND NOTHING.

- ☒ 3" ANGLE IRON SET IN CONCRETE
- ▲ POINT ON A LINE BETWEEN THE NE & NW CORNER AT PROPORTIONATE DISTANCE.

