

180  
V-5

# PLAT AND RECORD


Of a Survey on Section 30 4 11 PORTER  
25 T 4 R 10 E. of the 4 P. M. in UNION Township  
Rock County, Wisconsin, made JULY the 2 1976

**MICROFILMED**

I hereby certify that the following is a correct record of said survey as made by me.

COUNTY BUILDING  
CITY OF JANESVILLE

*Donald Barnes*

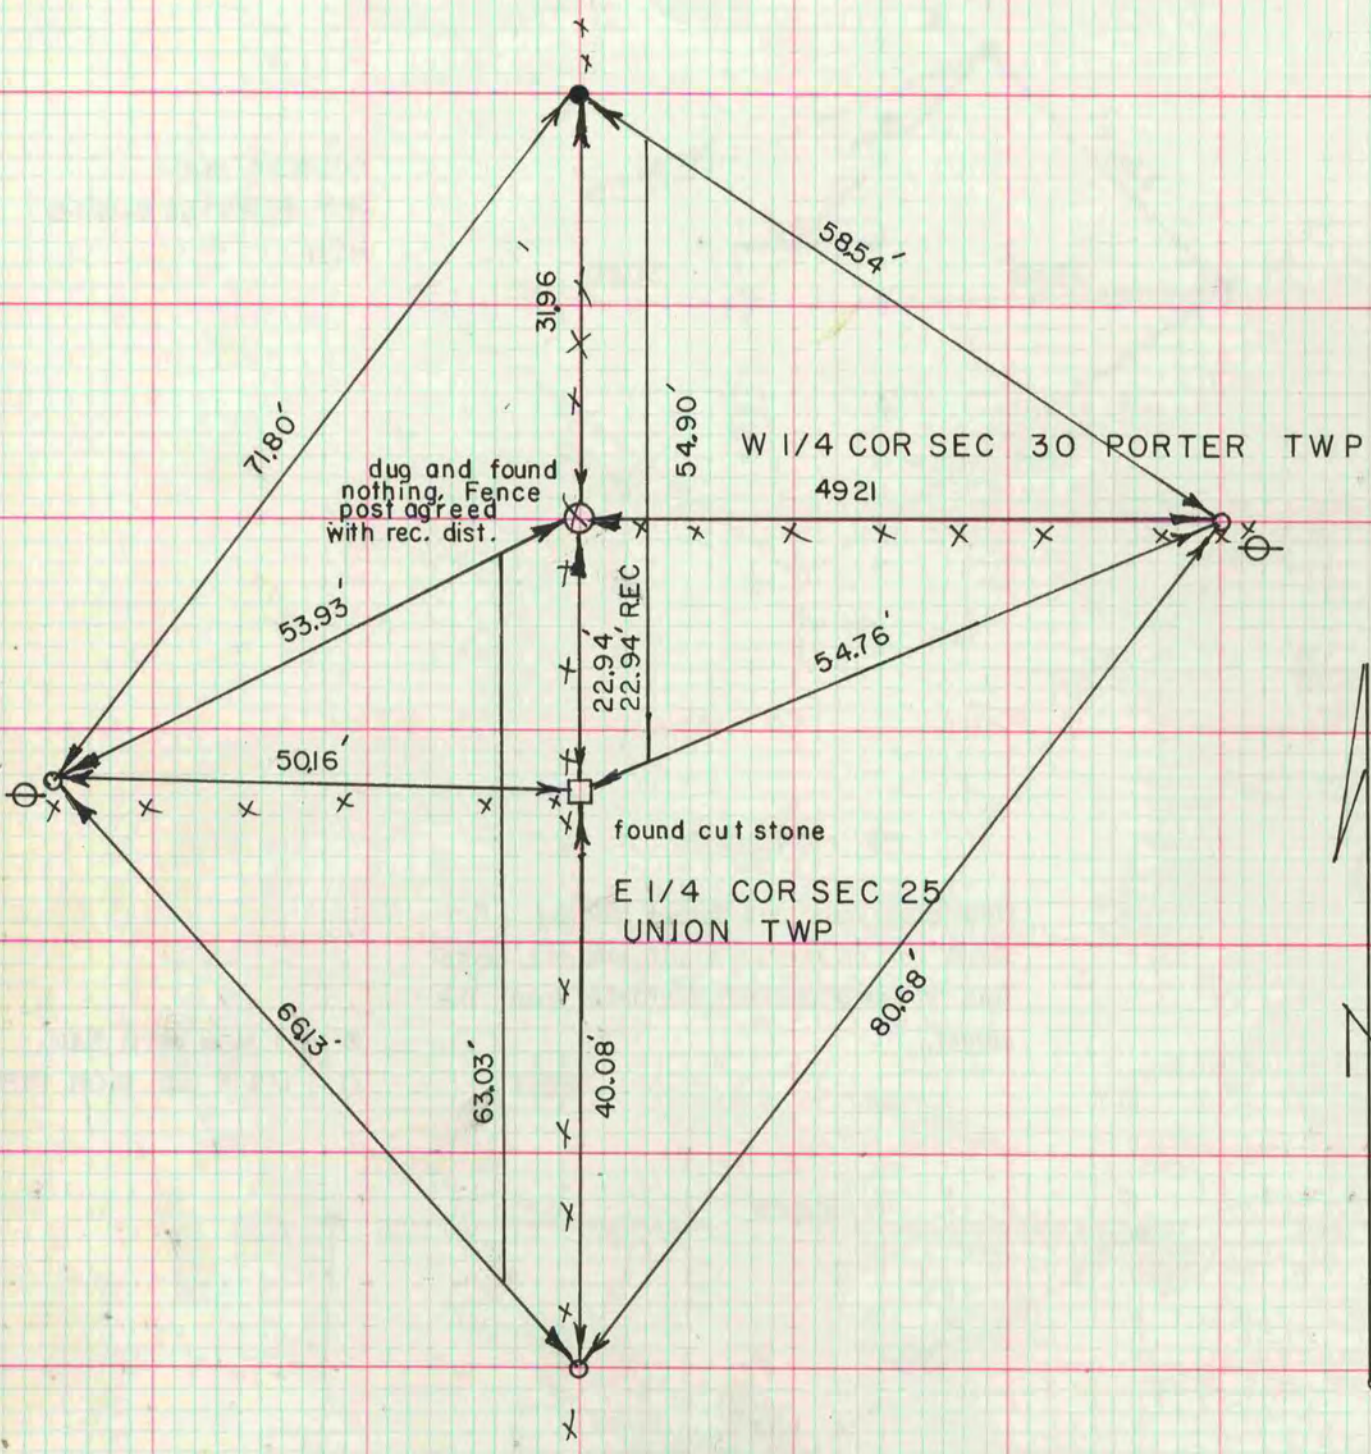

- 1 1/4" X 24" IRON PIPE
- G.I. PISTON MON WITH CAP