

COUNTY BUILDING  
CITY OF JANESVILLE

# PLAT AND RECORD VOL. 5

81  
2-5

COUNTY BUILDING  
CITY OF JANESVILLE

Of a Survey on Section 30 T. 1 R. 11 E. of the 4 P. M. in NEWARK Township

Rock County, Wisconsin, made MAY the 19 75


I hereby certify that the following is a correct record of said survey as made by me.

**MICROFILMED**

*Olaf Schroeder*  
County Surveyor.

MAY 23 1975

O.F.S.  
R.P.

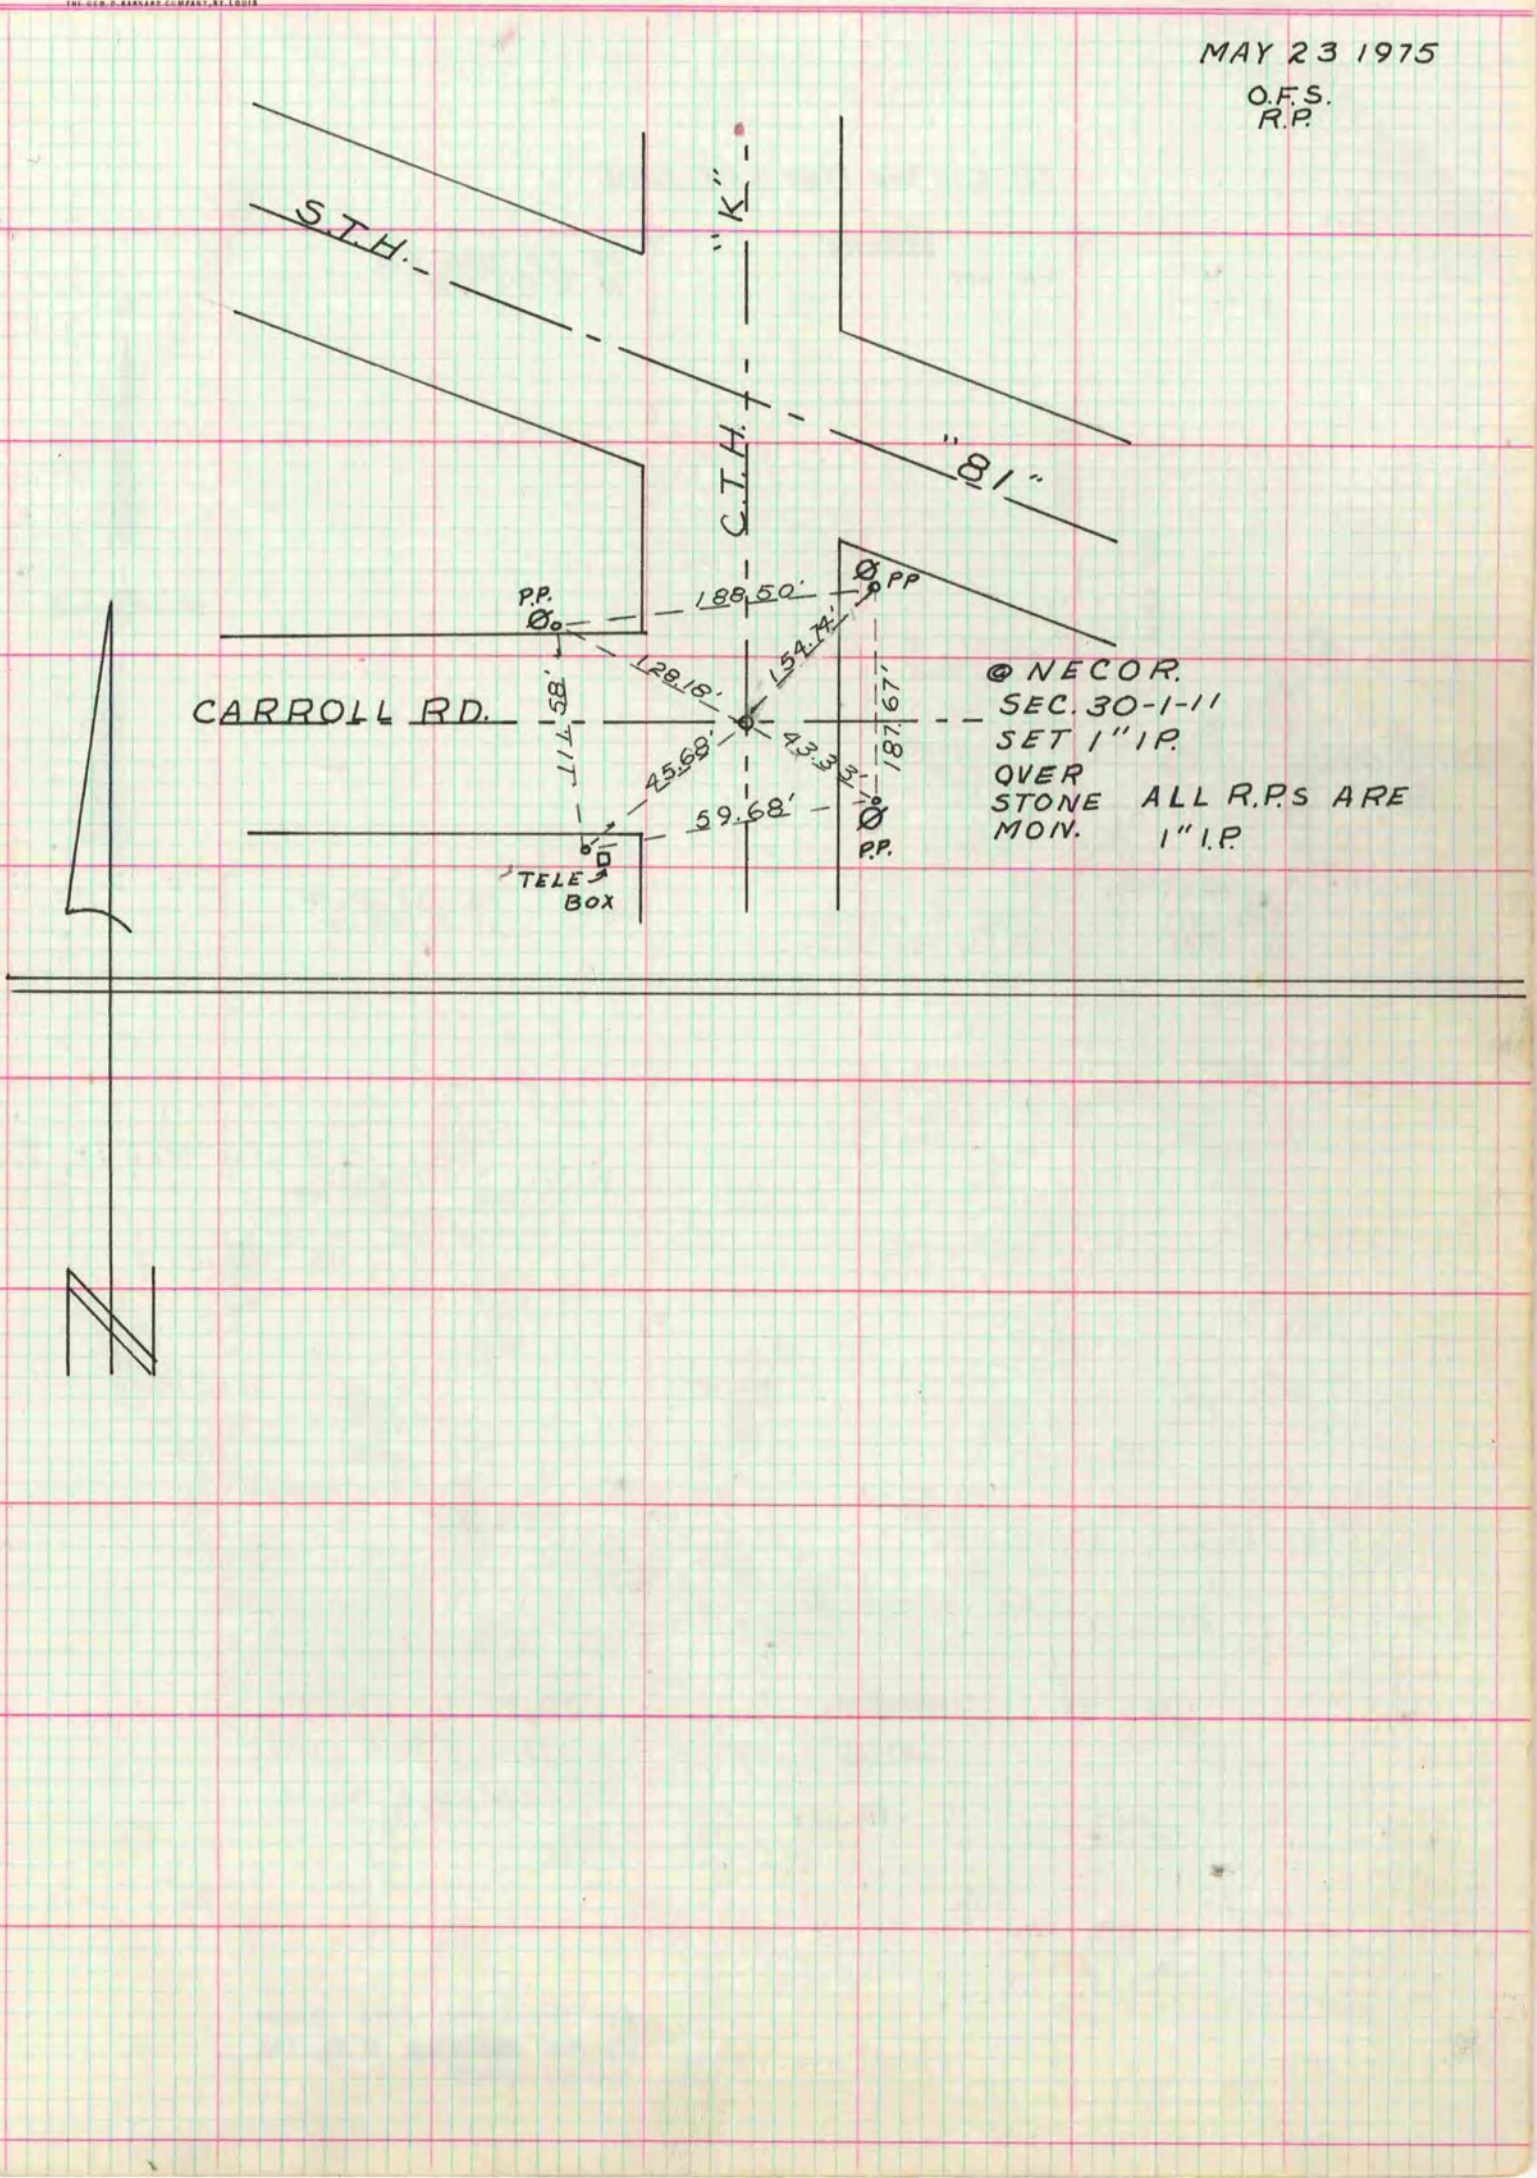

@ NECOR.  
SEC. 30-1-11  
SET 1" I.P.  
OVER  
STONE ALL R.P.S ARE  
MON. 1" I.P.