

PLAT AND RECORD

139

V-5


COUNTY BUILDING
CITY OF JANESVILLE

Of a Survey on Section 24 T 1 N R 14 E. of the 4 P. M. in CLINTON Township

Rock County, Wisconsin, made MARCH the 5 1976

I hereby certify that the following is a correct record of said survey as made by me.

Donald Barnes

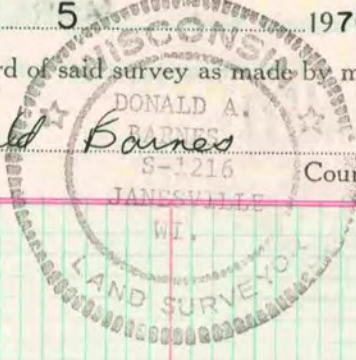

County Surveyor.

MICROFILMED

