

PLAT AND RECORD

519
V-3

COUNTY BUILDING
CITY OF JANESVILLE

Of a Survey on Section 19 T 4 N R 11 E. of the 4 P. M. in PORTER Township


Rock County, Wisconsin, made AUGUST 1st To the 6th 1957

I hereby certify that the following is a correct record of said survey as made by me.

MICROFILMED

COUNTY BUILDING
CITY OF JANESVILLE

R. B. Batterman III
County Surveyor.

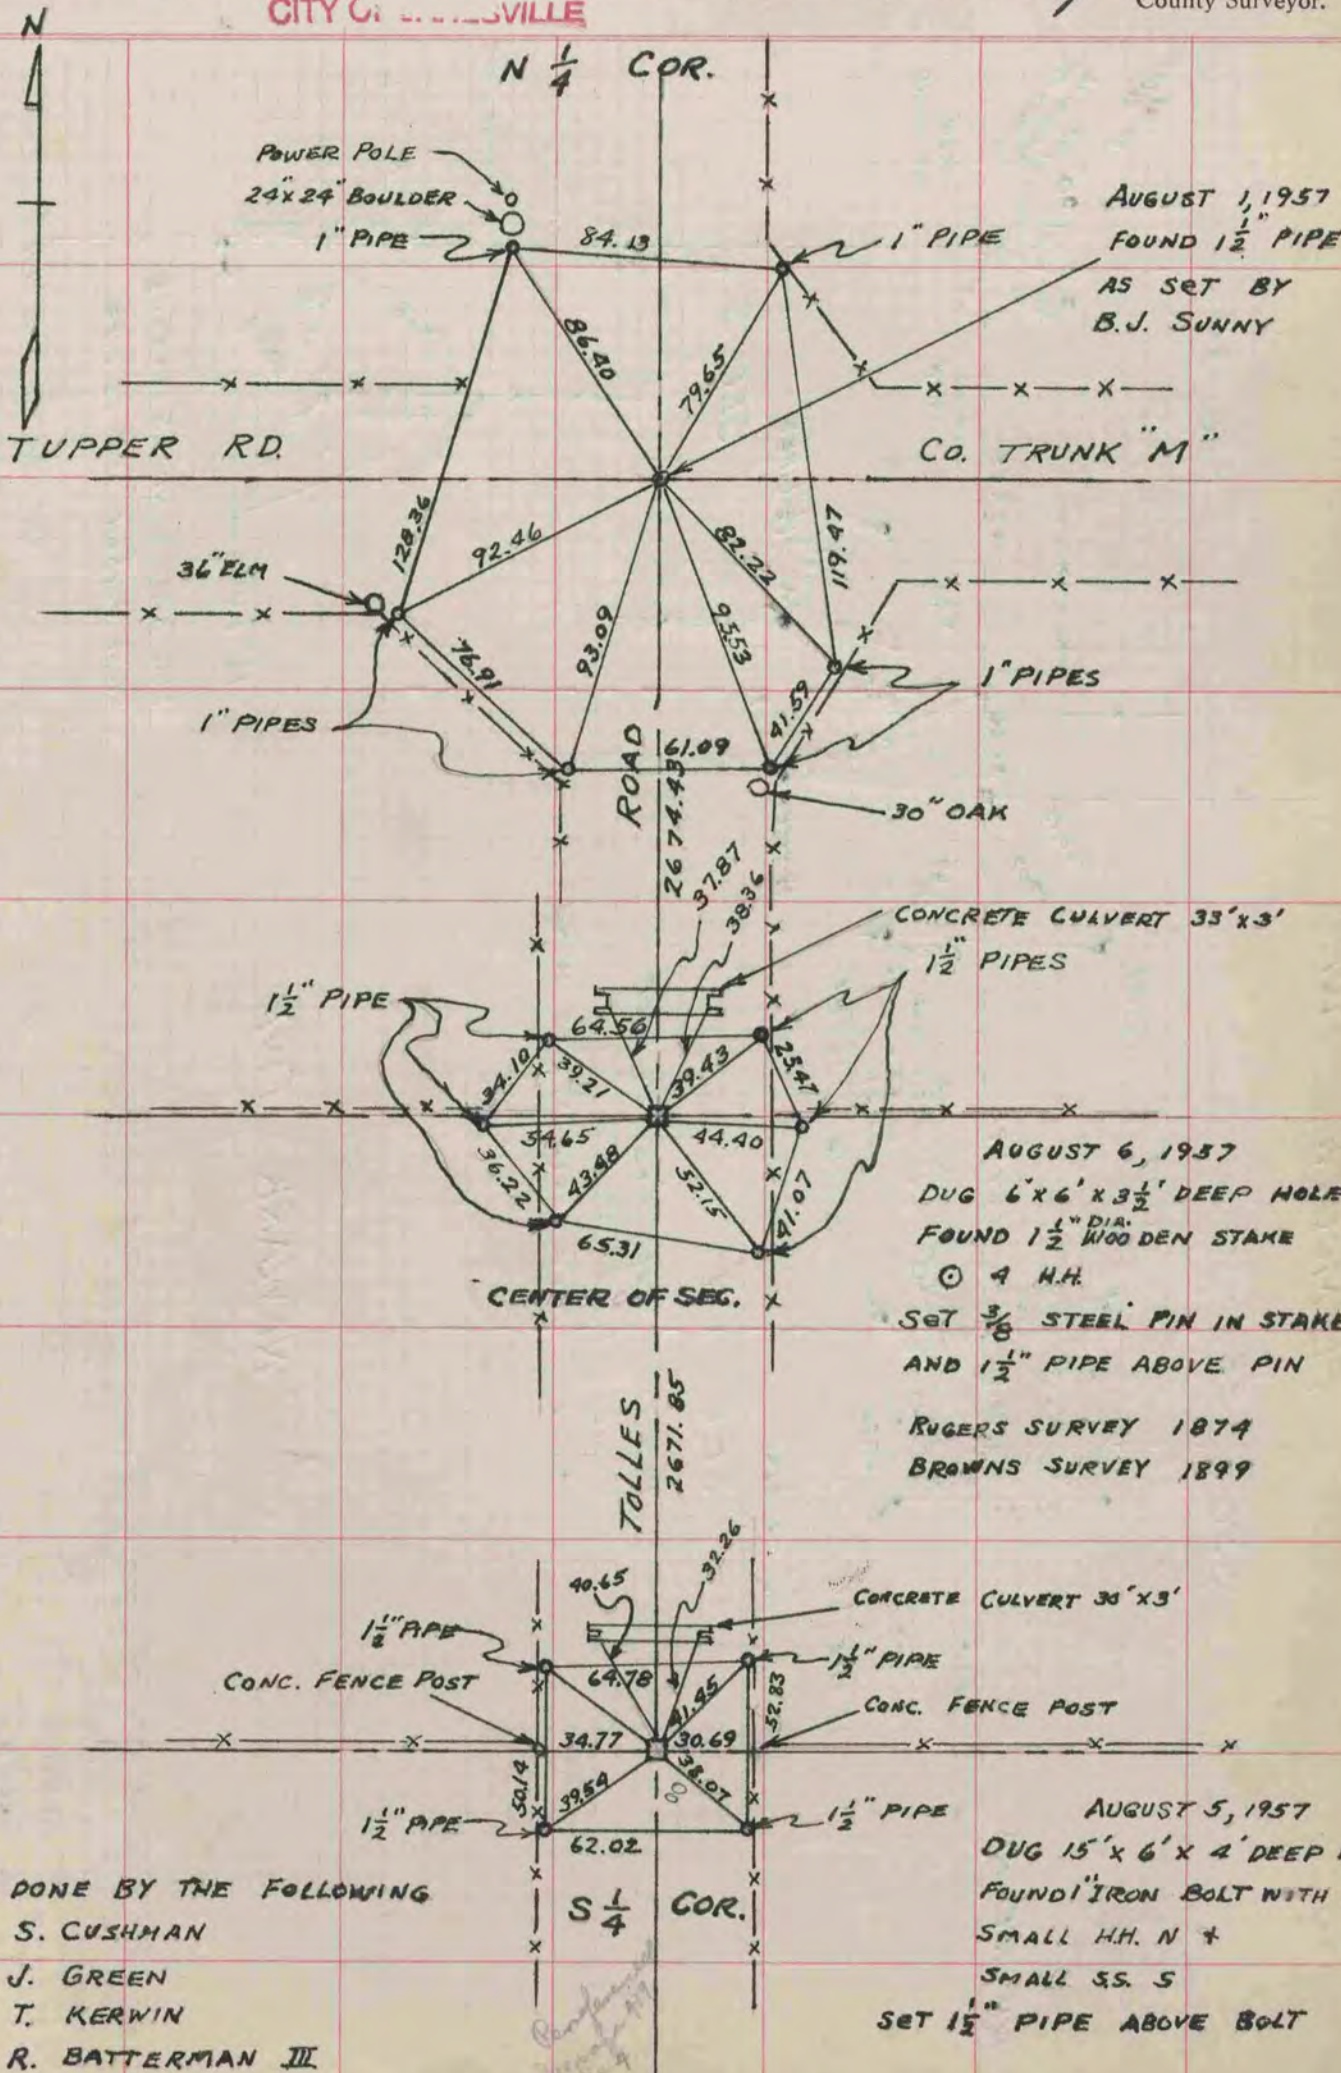

WORK DONE BY THE FOLLOWING
S. CUSHMAN
J. GREEN
T. KERWIN
R. BATTERMAN III

COUNTY BUILDING
CITY OF JANESVILLE