

PLAT AND RECORD

COUNTY BUILDING
CITY OF JANESVILLE

155
VJ4


Of a Survey on Section 15, 22 T 3N R 13 E. of the 4 P. M. in HARMONY Township

Rock County, Wisconsin, made NOV. the 16 1963

MICROFILMED

I hereby certify that the following is a correct record of said survey as made by me.

Robert E. Kerwin
County Surveyor.

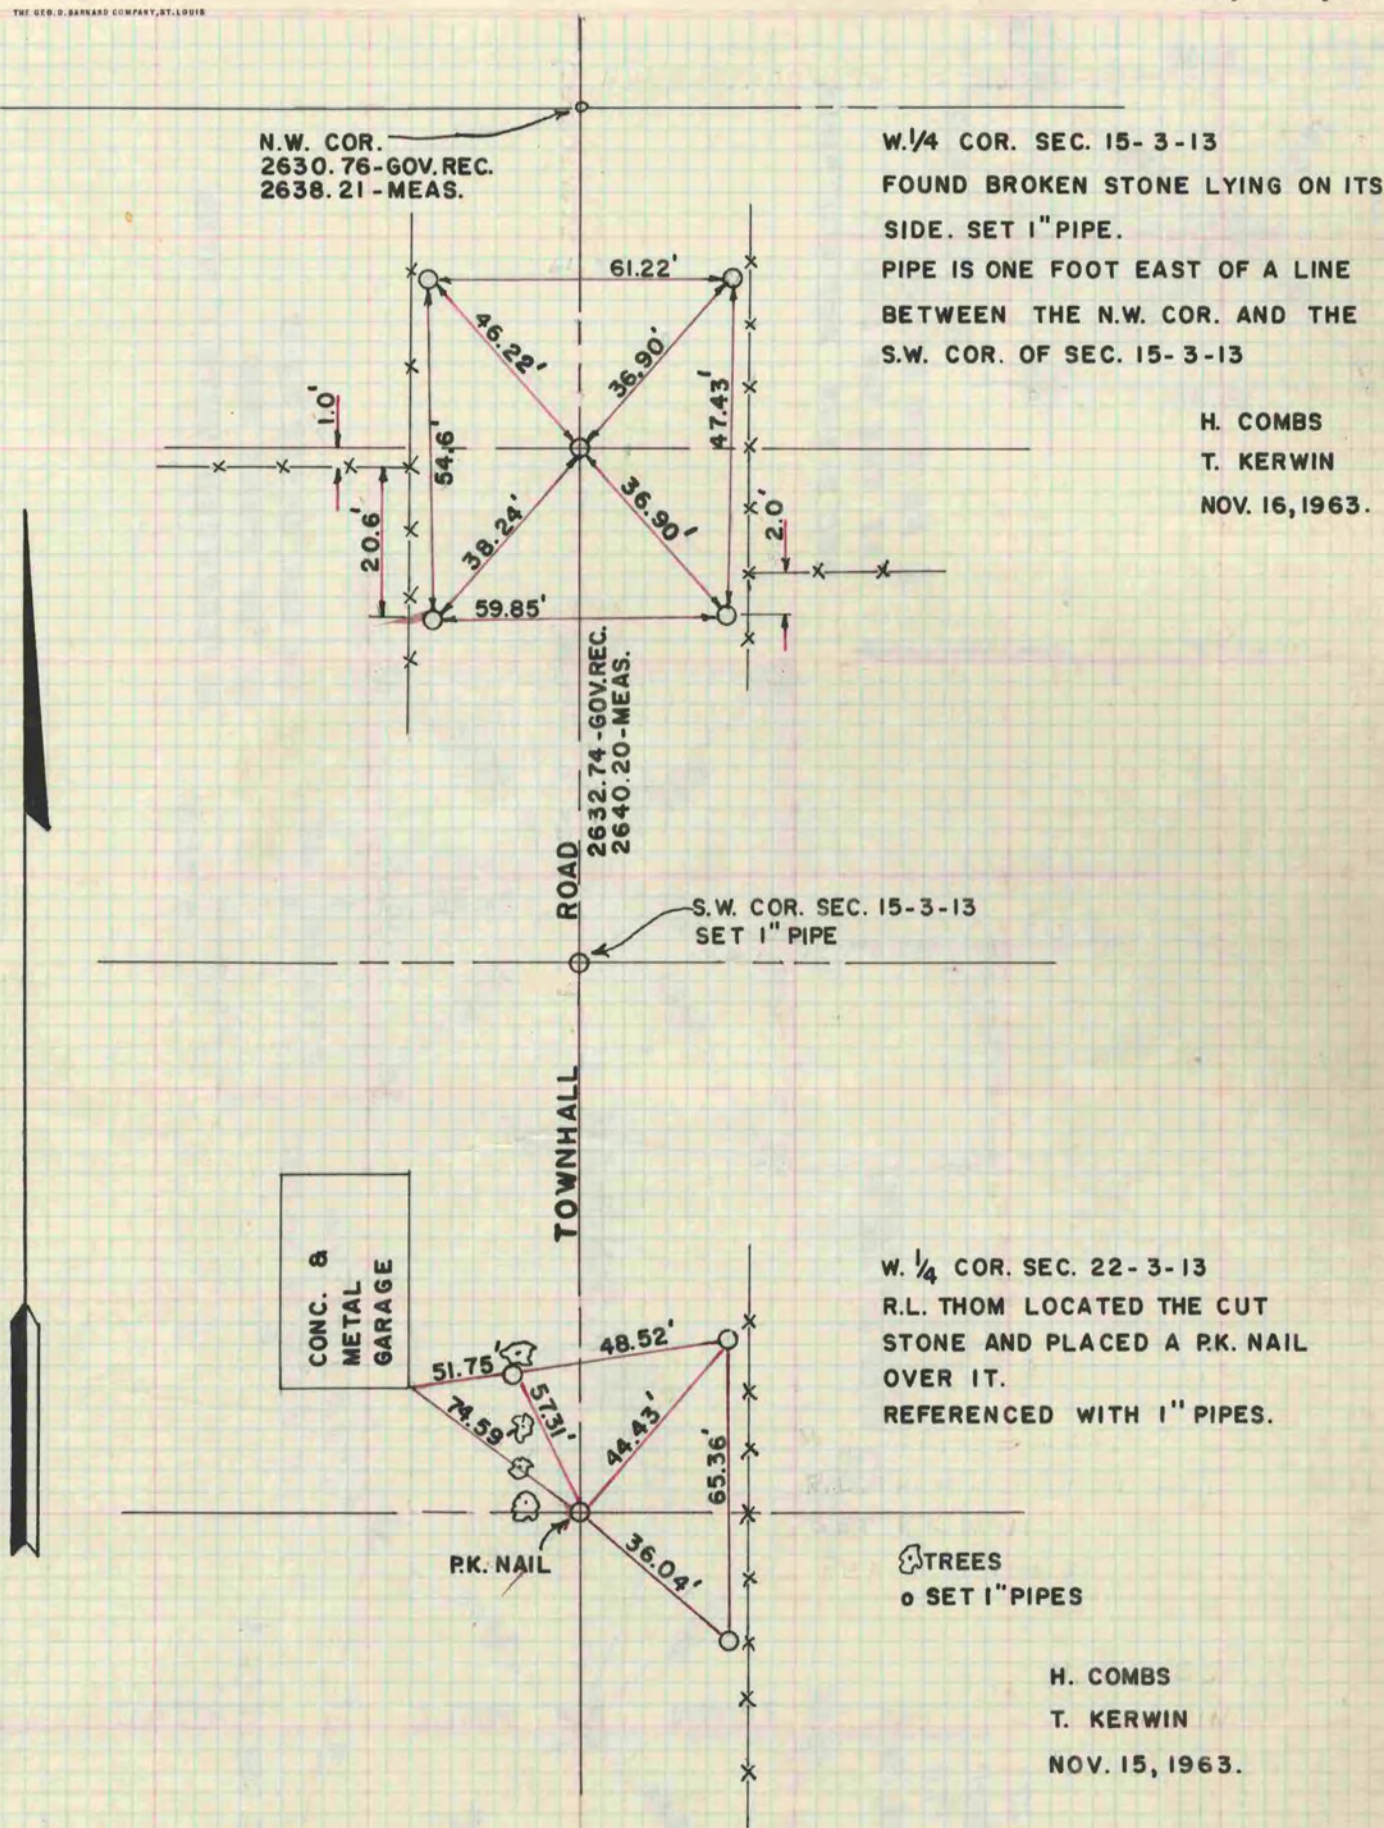

H. COMBS
T. KERWIN
NOV. 16, 1963.

H. COMBS
T. KERWIN
NOV. 15, 1963.