

**MICROFILMED**

# PLAT AND RECORD


Of a Survey on Section 15 T 2 R 13 E. of the 4 P. M. in Harmony Township  
Rock County, Wisconsin, made May the 26<sup>th</sup> 1873

I hereby certify that the following is a correct record of said survey as made by me.

COUNTY BUILDING  
CITY OF JANESVILLE

(Signed) R. H. Lee  
R. H. B.

Deputy  
County Surveyor.

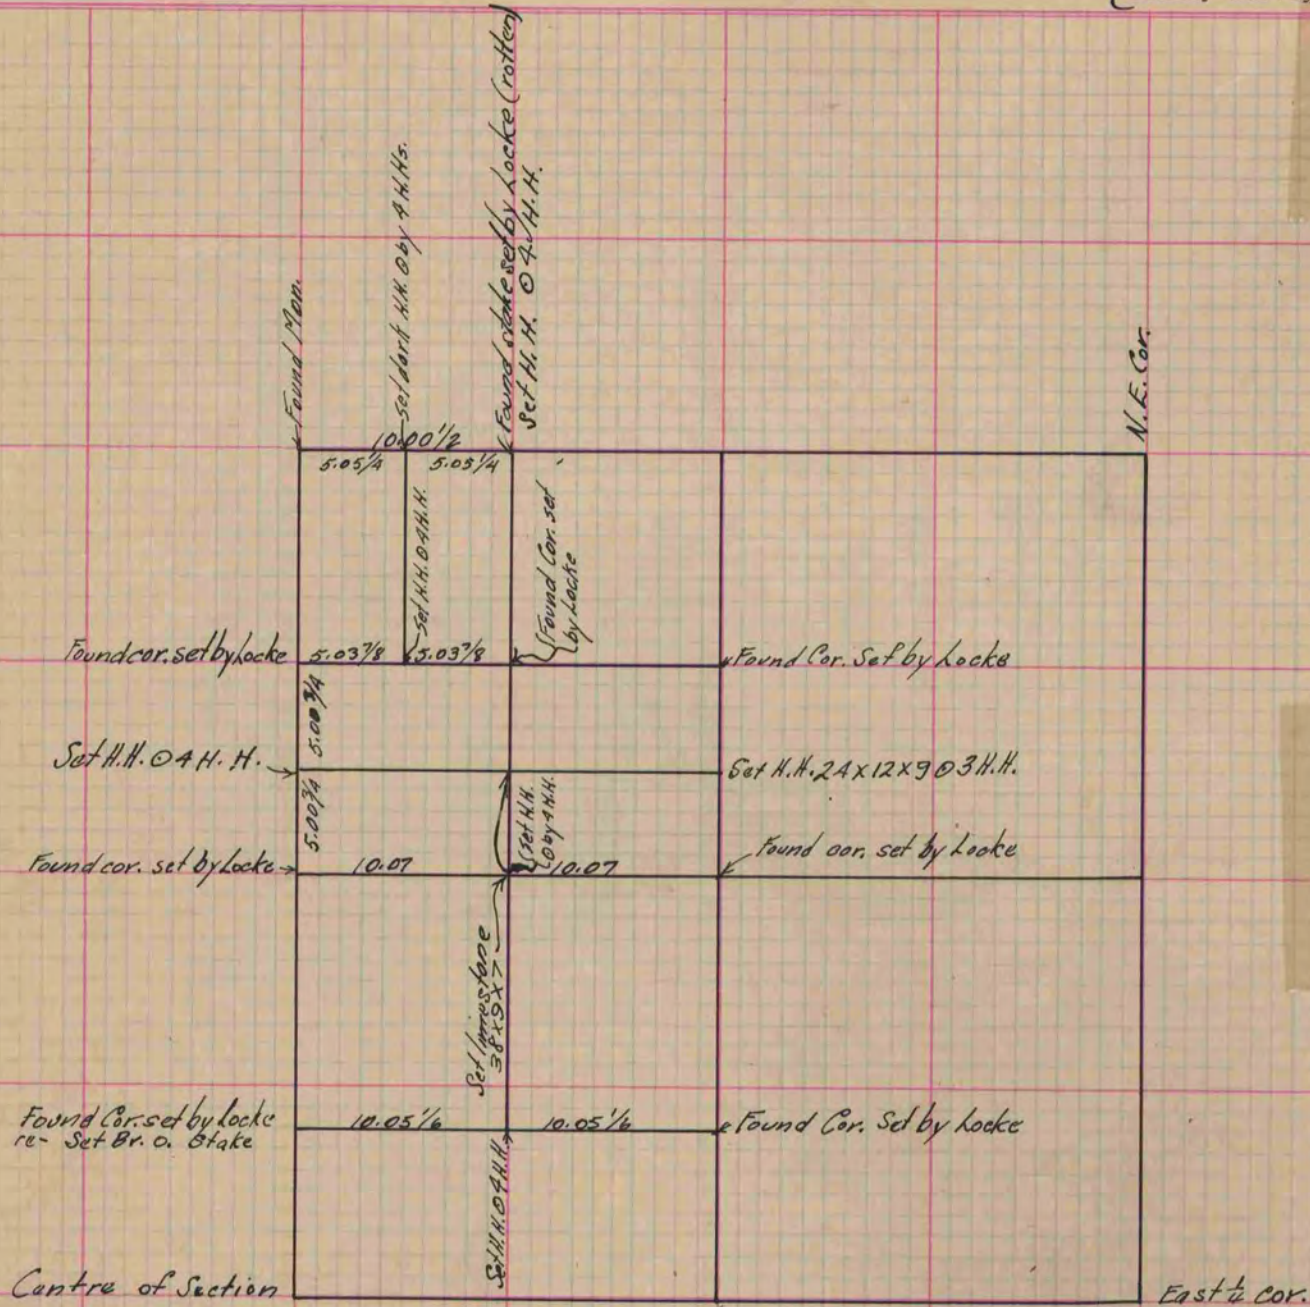

Copied from Page 59 Vol. 2. Original County Surveyors Record