

U.S. PUBLIC LAND SURVEY MONUMENT RECORD


For Public Land Survey Corners in the
T. 3 N., R. 13 E.

CORNER CODE INDEX

	1	2	3	4	5	6	7	8	9	10	11	12	13	14	15	16	17	18	19	20	21	22	23	24	25
A																									
B																									
C		6																							
D																									
E																									
F																									
G																									
H		7																							
I																									
J																									
K																									
L																									
M																									
N																									
O																									
P		9																							
Q																									
R																									
S																									
T																									
U		30																							
V																									
W																									
X																									
Y																									
Z																									

PLACE MONUMENT SYMBOL (◆) AT PROPER LOCATION ON ABOVE INDEX

EXAMPLE

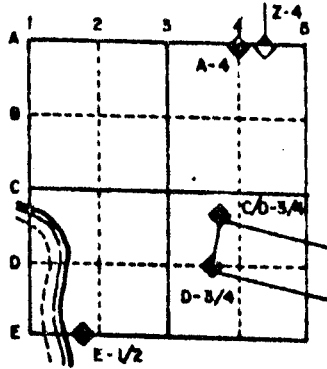

HARMONY TWP
ROCK COUNTY WI

IF AVAILABLE
STATE PLANE COORDINATES

North (Y) _____ Eleve. (Z) _____
 East (X) _____ Zone _____
 Hor. Datum _____ Vert. Datum _____

e.)

◆ CORNER MONUMENT


○ WITNESS MONUMENT

BEARINGS ARE BASED ON: ASSUMED


MICROFILMED

SHEET 1 OF 1

CORNER CODE: X 9 (1)(A)

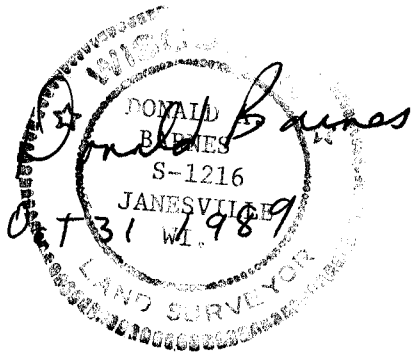

Book 2
PAGE 64

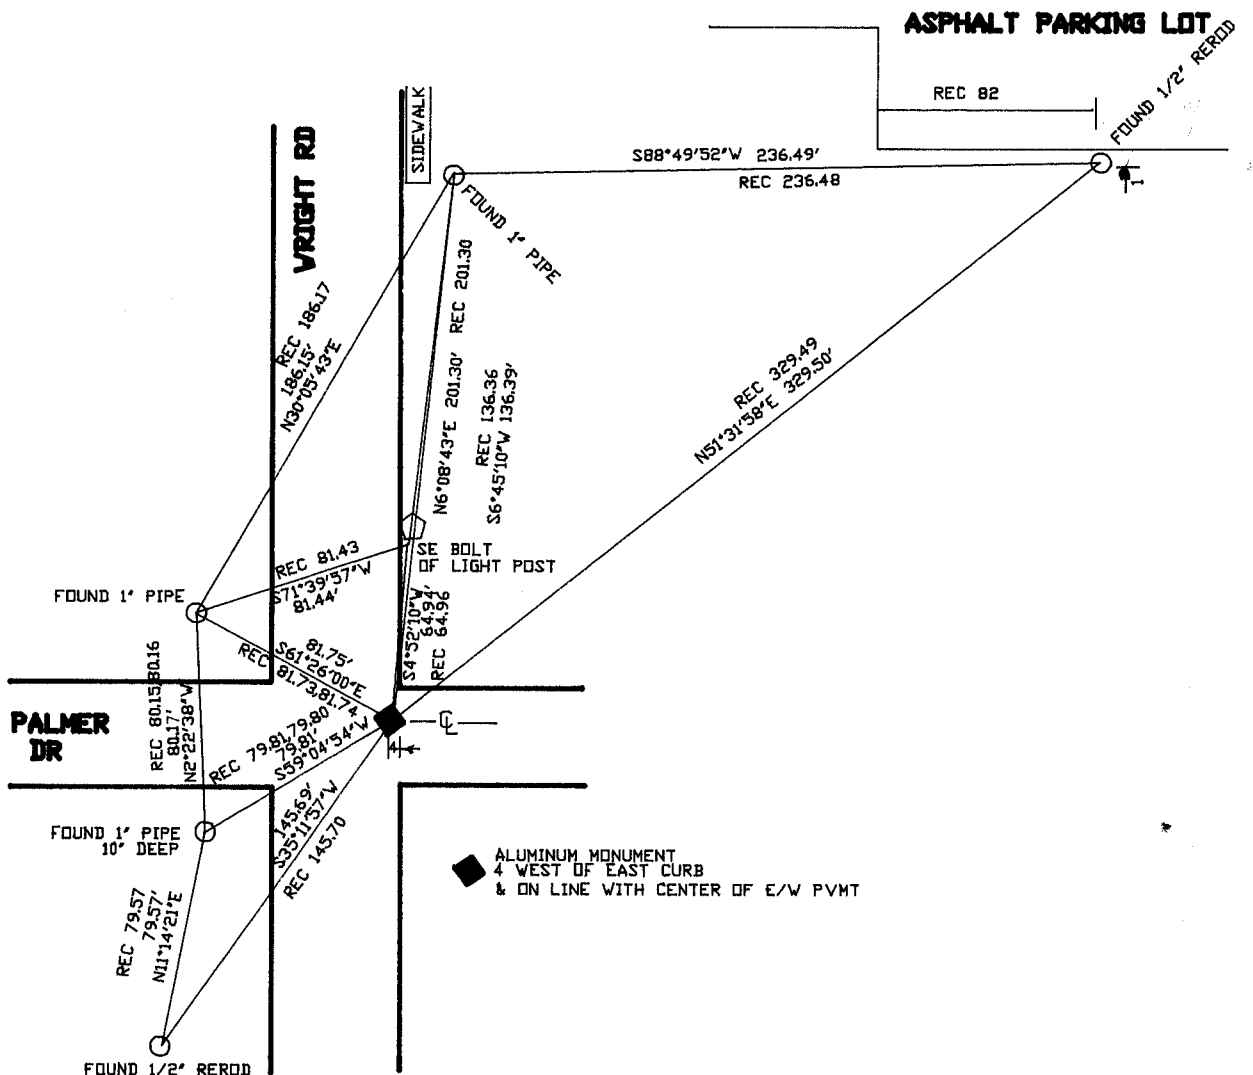

X 9(1)
(A)