
## U.S. PUBLIC LAND SURVEY MONUMENT RECORD

For Public Land Survey Corners in:

WI ADMINISTRATIVE CODE A-E 7.08 REQUIREMENT

T. 2N., R. 10 E

CORNER CODE INDEX

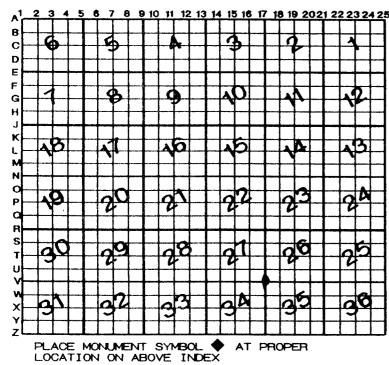

| MAG  | TWI    |    |
|------|--------|----|
| ROCK | COUNTY | WI |

IF AVAILABLE ROCK COUNTY COORDINATES PERFERRED

| North Elev                      |
|---------------------------------|
| East                            |
| Hor. Datum Vert. Datum          |
| LATITUDEELLIPS. HT.             |
| LONGITUTE                       |
| GPS (X) TRAVERSE (X)            |
| BASED ON THE FOLLOWING CONTROL: |
|                                 |

♦ CORNER MONUMENT

WITNESS MONUMENT

BEARINGS ARE BASED ON:

(a)

|   |            |         | ,          |
|---|------------|---------|------------|
| FIELD BOOKPAGE #  | SHEET      | OF      |            |
| SHOW A PLAN VIEW DRAWING DEPICTING THE CORNER MONUMENT          | AND SURRO  | DUNDING |            |
| PHYSICAL FEATURES, INCLUDING THE EXCAVATION AREA AND DEPTH      | ł <u>.</u> |         |            |
| PLANNING & ZONING COMMITTEE ADOPTED THE ABOVE FORM ON 12/2/1982 |            |         | <i>~</i> ~ |

## MA609

(B) Describe any record evidence, monument evidence, occupational evidence, testimonial evidence or any other material evidence you considered, and whether the monument was found or placed.

material evidence you considered, and whether the monument was found or placed.

1868 LOCKE VOL 1 PG 326 FOUND REMAINS OF B.T.'s & OLD STAKE. SET WHITE OAK STAKE WITH LARGE LIMESTONE ON NORTH & SMALLER LIMESTONES ON EAST, SOUTH, & WEST IN CENTER OF HIGHWAYS.

1869 LEE VOL 1 PG 353 FOUND CORNER SET BY LOCKE. VAR 7-00 2661.12 TO S 4 COR SEC 27 & VAR 9-00 2663.76 TO E 4 COR SEC 27.

1929 BATTERMAN VOL 3 PG 163 CORNER DUG OUT BY GRADING.

1967 BATTERMAN VOL 4 PG 336 CORNER GRADED OUT.

1974 LEE VOL 5 PG 17 SET FROM TRAVERSE & REFERENCED. STATES NO DISTANCES

DISTANCES

1988 BARNES V-17 FOUND SE & SW REFERENCE PIPES. USED REFERENCE PIPES TO ESTABLISH CORNER.

FD NOTHING AT CORNER. FOUND REFERENCE PIPES & AT NE REFERENCE PIPE FOUND OLD DOT DISK IN CONCRETE NON FROM OLD CTH B PROJECT. DISK IS 2.68' SE FROM THE NE REFERENCE PIN. FD TRAV. PK ON CTH B JUST WEST PAVENENT WILL BE DESTROYED. OF STH 213.

- C) Was the corner restored through acceptance of (1) an obliterated evidence location, or, (2) a found perpetuated location?
- D) Describe any material discrepancy between the location of the corner as restored or reestablished and the location of that corner as previously restored or reestablished by distance and direction. Show the discrepancy on the plan view drawing under (a), above. Show the distances between the corner as previously restored or reestablished and (1) the corner as restored or reestablished, and (2) to at least 4 of the witness monuments shown on the drawing in (a), above.
- (E) Was the corner reestablished through lost corner proportionate methods? If so, show the method, including the directions and distances to other public land survey corners used as evidence or used for proportioning the corner location.

I, Donald Barnes, hereby certify that the corner location as identified by the corner code index was determined by me under my direction and control and that this U.S. Public Land Survey Monument Record is correct and complete to the best of my knowledge and belief.

May 15, 2000

Number of included sheets 1

CORNER CODE V17(1)

**A-E 7.08 REQUIREMENT**