

U.S. PUBLIC LAND SURVEY MONUMENT RECORD

For Public Land Survey Corners in the


T. 3 N., R. 10 E.

CORNER CODE INDEX

	1	2	3	4	5	6	7	8	9	10	11	12	13	14	15	16	17	18	19	20	21	22	23	24	25
A																									
B																									
C	6				5				4					3						2					
D																									
E																									
F																									
G	7				8				9					10						11					
H																									
J																									
K																									
L	18				17				16					15						14					
M																									
N																									
O																									
P	19				20				21					22						23					
Q																									
R																									
S																									
T	30				29				28					27						26					
U																									
V																									
W																									
X	31				32				33					34	◆	35				36					
Y																									
Z																									

PLACE MONUMENT SYMBOL (◆) AT PROPER LOCATION ON ABOVE INDEX

EXAMPLE

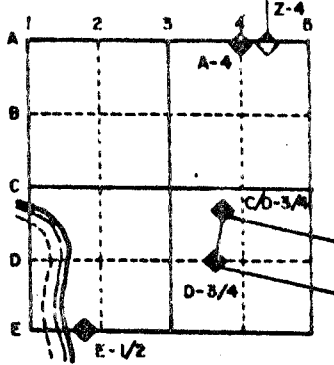

MAGNOLIA TWP
ROCK COUNTY WI

IF AVAILABLE
STATE PLANE COORDINATES

North (Y) _____ Eleve. (Z) _____
 East (X) _____ Zone _____
 Hor. Datum _____ Vert. Datum _____

a.)

◆ CORNER MONUMENT

○ WITNESS MONUMENT

BEARINGS ARE BASED ON:

MICROFILMED


SHEET ___ OF ___

CORNER CODE: X 170


FIELD SURVEY NOTES
PRESERVATION OF LANDMARKS
 (Pursuant to Section 59.635(7) Wisconsin Statutes)

State Highway Commission of Wisconsin
 Form E-D-707-65


COUNTY <i>Rock</i>		
TOWN <i>Magnolia</i>		
HIGHWAY <i>STH 213</i>		
SECTION <i>35</i>	TOWNSHIP <i>3 N</i>	RANGE <i>10 E</i>
TYPE OF LANDMARK <i>1 1/2" Pipe</i>		

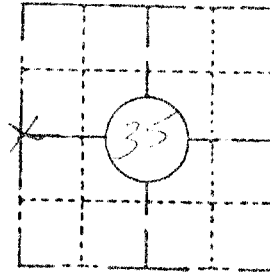

LOCATION SKETCH
 (Location of landmark indicated by "x")

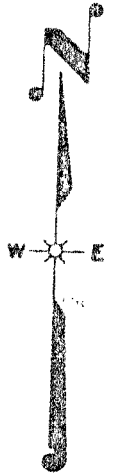

This space for copy of field notes or ties to the above described landmarks

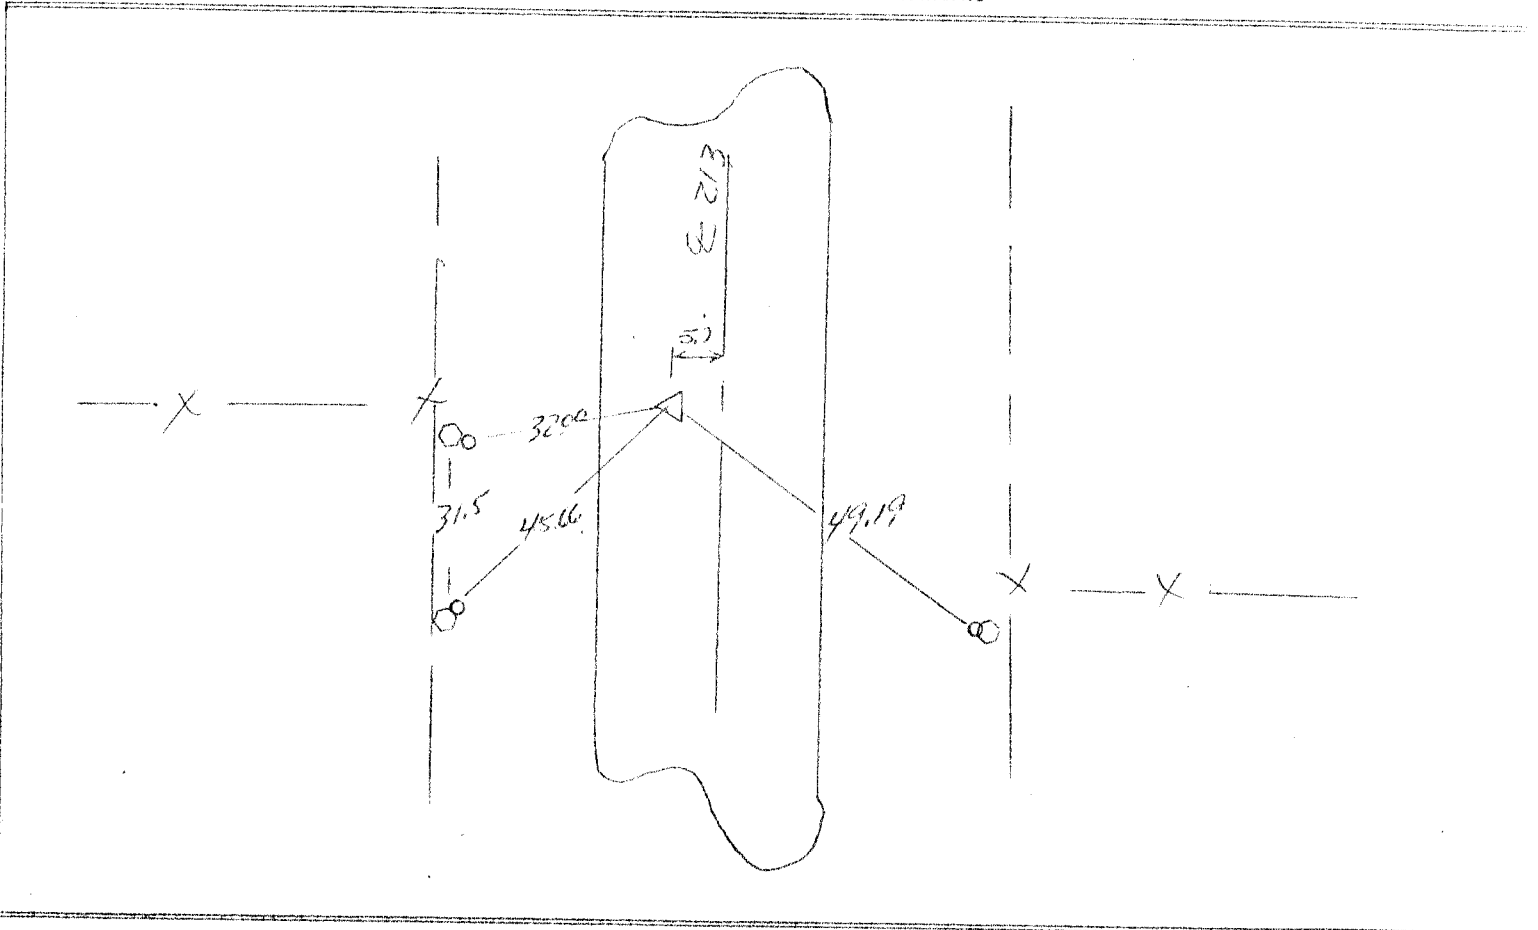

- = REFERENCE MONUMENT *4 5 Box*
- = RIGHT OF WAY POST
- ◊ = WITNESS POST
- △ = SECTION CORNER LOCATION

COUNTY CLERK'S OFFICE	
COUNTY OF	WISCONSIN } 55
DATE RECEIVED FOR RECORD	DATE COPY SENT TO COUNTY SURVEYOR <i>8/15</i>
SIGNATURE OF COUNTY CLERK	

X 170