

Paper weight-110# (minimum)

Black nonfading ink required

U.S. PUBLIC LAND SURVEY MONUMENT RECORD

For Public Land Survey Corners In:
T. 4 N. R. 11 E. 4th P.M.

WI ADMINISTRATIVE CODE A-E 7.08 REQUIREMENT

REV 10/23/2004 USMONREC.DWG

CORNER CODE INDEX

PORTER TWP
ROCK COUNTY WI

IF AVAILABLE
ROCK COUNTY COORDINATES PREFERRED

1	2	3	4	5	6	7	8	9	10	11	12	13	14	15	16	17	18	19	20	21	22	23	24	25	
A																									A
B																									B
C	6																								C
D																									D
E																									E
F																									F
G																									G
H																									H
J																									J
K																									K
L																									L
M																									M
N																									N
O																									O
P																									P
Q																									Q
R																									R
S																									S
T																									T
U																									U
V																									V
W																									W
X																									X
Y																									Y
Z																									Z
1	2	3	4	5	6	7	8	9	10	11	12	13	14	15	16	17	18	19	20	21	22	23	24	25	

North _____ Elev. _____

East _____

Hor. Datum _____ Vert. Datum _____

LATITUDE _____ ELLIPS. HT. _____

LONGITUDE _____

NAD83(91) _____ NETWORK ADJ. YR _____

GPS (X) _____ TRAVERSE (X) _____

BASED ON THE FOLLOWING CONTROL:

PLACE MONUMENT SYMBOL AT PROPER LOCATION ON ABOVE INDEX

CORNER MONUMENT

WITNESS MONUMENT

BEARINGS ARE BASED ON: _____

FIELD BOOK _____ PAGE # _____

SHEET 1 OF 3

SHOW A PLAN VIEW DRAWING DEPICTING THE CORNER MONUMENT AND SURROUNDING PHYSICAL FEATURES, INCLUDING THE EXCAVATION AREA AND DEPTH.

PLANNING & ZONING COMMITTEE ADOPTED THIS FORM ON 12/2/1982

CORNER CODE N-20

FD DISTURBED PIPE THAT I SET IN 1975 IN CORN FIELD. I REPLACED IT WITH A 1/2X24" REROD. E/W FENCE IS GONE. ALSO FD EASTERN REF. PIPE. I BELIEVE THERE IS A PROBLEM WITH BATTERMAN'S 1958 TIES.

BY VIEWING THE 1950'S AIRPHOTOS IT APPEARS THE TIES SHOULD BE ROTATED BY NINETY DEGREES. IT SEEMS VERY UNLIKELY THAT REFERENCE PIPES WOULD BE PLACED 117' EASTERLY/WESTERLY APART FROM EACH OTHER. IT SEEMS MORE LIKELY TO BE 48' EASTERLY/WESTERLY APART, WHICH WOULD PLACE THEM ALONG THE N/S R/W FENCE LINE AND NOT IN THE FIELDS. I WAS NOT ABLE TO FIND THE ORIGINAL FIELD NOTES. I SEARCHED AND DID NOT FIND HIS REFERENCE MONUMENTS. BATTERMAN'S HH WITH A HH ON THE N & S DOESN'T FIT RUGERS CALL OF A STAKE SURROUNDED BY LARGE HH STONES. ALSO THE LOCATION DOESN'T FIT THE 1857 STEBBIN PORTER TWP RD REC BK 1 PG 9, WHICH CALLS FOR A POINT 33' EAST OF THE LINE THAT DIVIDED THE EAST 1/2 OF SEC 14; THENCE SOUTH PARALLEL WITH AND 33' FROM THE LINE DIVIDING THE SE 1/4 OF SEC 14 AND THE NE 1/4 OF SEC 23.


C) Was the corner restored through acceptance of (1) an obliterated evidence location, or, (2) a found perpetuated location?

ACCEPTED FD PIPE THAT I SET IN 1975, WHICH THEN WAS 3' WEST OF THE N/S & E/W FENCE LINE. THIS LOCATION IS IN HARMONY WITH RUGER'S DISTANCES AND THE ROAD RECORD.

D) Describe any material discrepancy between the location of the corner as restored or reestablished and the location of that corner as previously restored or reestablished by distance and direction. Show the discrepancy on the plan view drawing under (a), above. Show the distances between the corner as previously restored or reestablished and (1) the corner as restored or reestablished, and (2) to at least 4 of the witness monuments shown on the drawing in (a), above.

(E) Was the corner reestablished through lost corner proportionate methods? If so, show the method, including the directions and distances to other public land survey corners used as evidence or used for proportioning the corner location.

I, **DONALD BARNES**, hereby certify that the corner location as identified by the corner code index was determined by me under my direction and control and that this U.S. Public Land Survey Monument Record is correct and complete to the best of my knowledge and belief.

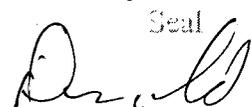Seal

Emboss
Barnes

10-27-2009

SHEET 2 OF 3

CORNER CODE **N-20**

A. E. 7. 08 REQUIREMENT



N 1/16TH COR
 NE 1/4
 SEC 23
 PORTER TWP
 T4N R11E

FD PIPE
 REPLACED WITH
 1/2 REROD


1977 BARNES VOL 5 PG 254
 FB#1 PG 46 & 48

SEARCHED
 & FD NOTHING
 IN CORN
 FIELD

FENCE GONE

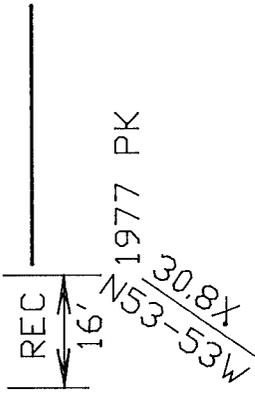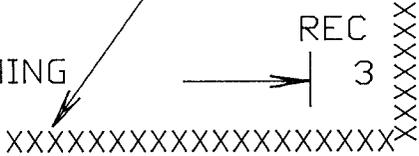

N80-40-08E 9.78

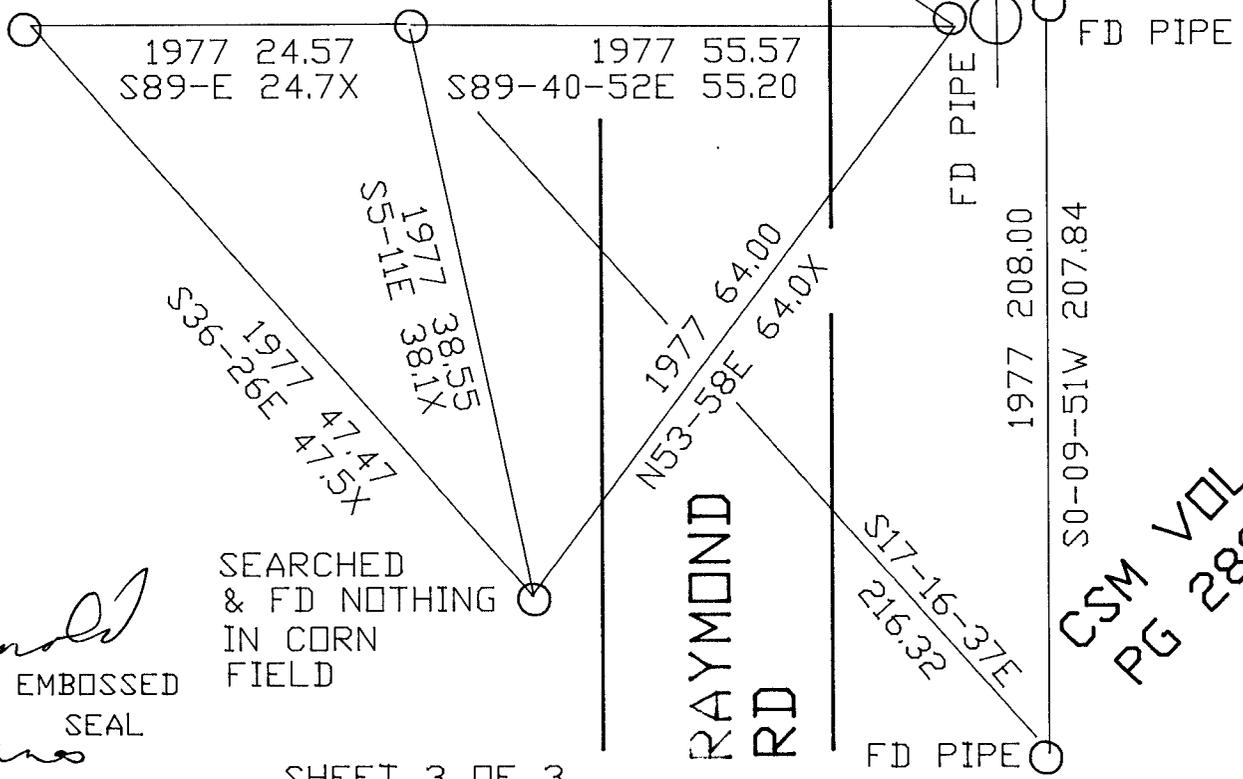

SEARCHED
 & FD NOTHING
 IN CORN
 FIELD

Donald Barnes
 EMBOSSED
 SEAL

CSM VOL 6
 PG 280

10-27-2009