
LAND **SURVEY** U.S. **PUBLIC** MONUMENT RECORD

For Public Land Survey Corners in:

WI ADMINISTRATIVE CODE A-E 7.08 REQUIREMENT

T. 3N., R. 13E

CORNER CODE INDEX

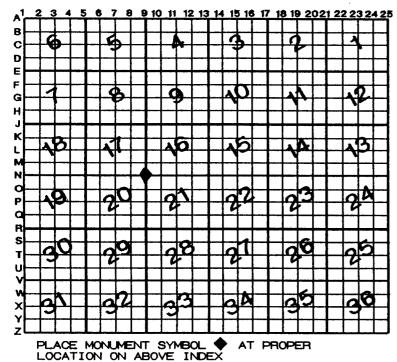

HARMONY		TWP
ROCK	COUNTY	WI

IF AVAILABLE ROCK COUNTY COORDINATES PERFERRED

North Elev
East
Hor. Datum Vert. Datum
LATITUDE ELLIPS. HT
LONGITUTE
GPS (X) TRAVERSE (X)
BASED ON THE FOLLOWING CONTROL:

♦CORNER MONUMENT

O WITNESS MONUMENT

BEARINGS ARE BASED ON:

(a)

ullet . The state of the state of $ullet$ is the state of $ullet$.		
	SHEET OF	7
FIELD BOOKPAGE #	SHEET OF	<u></u>
SHOW A PLAN VIEW DRAWING DEPICTING THE CORNER MONUMENT AND	SURROUNDING	
PHYSICAL FEATURES, INCLUDING THE EXCAVATION AREA AND DEPTH.		
PLANNING & ZONING COMMITTEE ADOPTED THE ABOVE FORM ON 12/2/1982		

HA565

(B) Describe any record evidence, monument evidence, occupational evidence, testimonial evidence or any other material evidence you considered, and whether the monument was found or placed.

1984 BARNES N-9 FOUND CUT LIMESTONE & REFERENCED SAME.

1995 BARNES N-9(1) FOUND LARGE PIECES OF CUT LIMESTONE WITH 3/8" REROD IN THE CENTER & CARSONITE POST.

MONUMENT DESTROYED BY STORM SEWER LINE. MANY OF THE SUBDIVISION MONUMENTS THAT WERE USED AS REFERENCE MONUMENTS WERE REPLACED AND USUALLY DID NOT AGREE WITH OLD MONUMENT RECORD. JIM WOODMAN PROVIDED DATA FROM CONTROL POINTS WHICH WAS USED TO PLACE AN ALUMINUM MONUMENT. THIS WAS IN HARMONY WITH OLD RECORD ANGLES AND DISTANCES. PLACED CARSONITE POST ON SOUTH SIDE OF MONUMENT. MONUMENT IS ABOUT .5 ABOVE GRADE.

- C) Was the corner restored through acceptance of (1) an obliterated evidence location, or, (2) a found perpetuated location?
 RESTORED CORNER THROUGH ACCEPTANCE OF OBLITERATED EVIDENCE LOCATION.
- D) Describe any material discrepancy between the location of the corner as restored or reestablished and the location of that corner as previously restored or reestablished by distance and direction. Show the discrepancy on the plan view drawing under (a), above. Show the distances between the corner as previously restored or reestablished and (1) the corner as restored or reestablished, and (2) to at least 4 of the witness monuments shown on the drawing in (a), above.

- (E) Was the corner reestablished through lost corner proportionate methods? If so, show the method, including the directions and distances to other public land survey corners used as evidence or used for proportioning the corner location.
- I, DONALD BARNES, hereby certify that the corner location as identified by the corner code index was determined by me under by direction and control and that this U.S. Public Land Survey Monument Record is correct and complete to the best of my knowledge and belief.

Pould Paired

Dec 31, 1997

emboss/stamped

Number of included sheets _

CORNER CODE

N-9(2)

