

# U.S. PUBLIC LAND SURVEY MONUMENT RECORD

For Public Land Survey Corners in:

WI ADMINISTRATIVE CODE A-E 7.08 REQUIREMENT

T. 3 N., R. 13 E

### CORNER CODE INDEX

A	1	2	3	4	5	6	7	8	9	10	11	12	13	14	15	16	17	18	19	20	21	22	23	24	25
B	6																								
C		5																							
D			4																						
E				3																					
F	1																								
G		8																							
H			9																						
I				10																					
J					11																				
K						12																			
L	18						15																		
M		17						16																	
N			18						15																
O				19						22															
P					20						23														
Q						21						24													
R							28																		
S	30							27																	
T		29							26																
U			28							25															
V				29																					
W					30																				
X	31																								
Y		32																							
Z			33																						

HARMONY TWP

ROCK COUNTY WI

IF AVAILABLE  
ROCK COUNTY COORDINATES PREFERRED

North \_\_\_\_\_ Elev. \_\_\_\_\_

East \_\_\_\_\_

Hor. Datum \_\_\_\_\_ Vert. Datum \_\_\_\_\_

LATITUDE \_\_\_\_\_ ELLIPS. HT. \_\_\_\_\_

LONGITUDE \_\_\_\_\_

GPS (X) \_\_\_\_\_ TRAVERSE (X) \_\_\_\_\_

BASED ON THE FOLLOWING CONTROL:

PLACE MONUMENT SYMBOL  AT PROPER LOCATION ON ABOVE INDEX

CORNER MONUMENT

WITNESS MONUMENT

(a)

BEARINGS ARE BASED ON:

FIELD BOOK \_\_\_\_\_ PAGE # \_\_\_\_\_

SHEET 1 OF 2

SHOW A PLAN VIEW DRAWING DEPICTING THE CORNER MONUMENT AND SURROUNDING PHYSICAL FEATURES, INCLUDING THE EXCAVATION AREA AND DEPTH.

PLANNING & ZONING COMMITTEE ADOPTED THE ABOVE FORM ON 12/2/1982

CORNER CODE J-13(2)

(B) Describe any record evidence, monument evidence, occupational evidence, testimonial evidence or any other material evidence you considered, and whether the monument was found or placed.

FD ALUM MON, MON WAS NOT  
DISTURBED BY ROAD AND SEWER  
PROJECT.

C) Was the corner restored through acceptance of (1) an obliterated evidence location, or, (2) a found perpetuated location?

ACCEPTED ALUM MON.

D) Describe any material discrepancy between the location of the corner as restored or reestablished and the location of that corner as previously restored or reestablished by distance and direction. Show the discrepancy on the plan view drawing under (a), above. Show the distances between the corner as previously restored or reestablished and (1) the corner as restored or reestablished, and (2) to at least 4 of the witness monuments shown on the drawing in (a), above.

NONE

(E) Was the corner reestablished through lost corner proportionate methods? If so, show the method, including the directions and distances to other public land survey corners used as evidence or used for proportioning the corner location.

I, DONALD BARNES hereby certify that the corner location as identified by the corner code index was determined by me under by direction and control and that this U.S. Public Land Survey Monument Record is correct and complete to the best of my knowledge and belief.

Donald Barnes  
seal

11/05/08

emboss/stamped

10F2  
Number of included sheets \_\_\_\_\_

A-E 7.08 REQUIREMENT

CORNER CODE

J-13(2)

NW COR SEC 15  
HARMONY TWP  
T3N R13E

1984- FD 1" PIPE. FD CUT  
LIMESTONE 12" DEEP.  
SET SHORT ALUM. MON  
ON TOP OF STONE

I WAS CONTACTED ABOUT  
DESTRUCTION OF MON BY  
SEWER & RD PROJ.  
ON SITE DESIGN CHANGE  
MON. WAS NOT DISTURBED

FD 1" PIN  
PROPERTY COR.  
MARKED WITH METAL  
FENCE POST  
ELEV 902.7  
PHOTO 904



ELEV 909.4  
PHOTO 908

FD BENT 1" PIPE  
REPLACED WITH 3/4X24  
REROD IN PIPE HOLE)  
TOP IS 0.6 BELOW  
GRADE

N44-43-25W  
CELL TOWER  
N54-46-30W 8,806'  
CABLE TV ANT.

1985 1"X24 PIPE  
NEXT TO STOP  
AREA DISTURBED &  
CONSTRUCTION EQUIP.  
@ LOCATION  
SIGN.

*Donald*  
EMBOSSSED  
SEAL  
*Baines*  
11/05/08

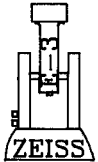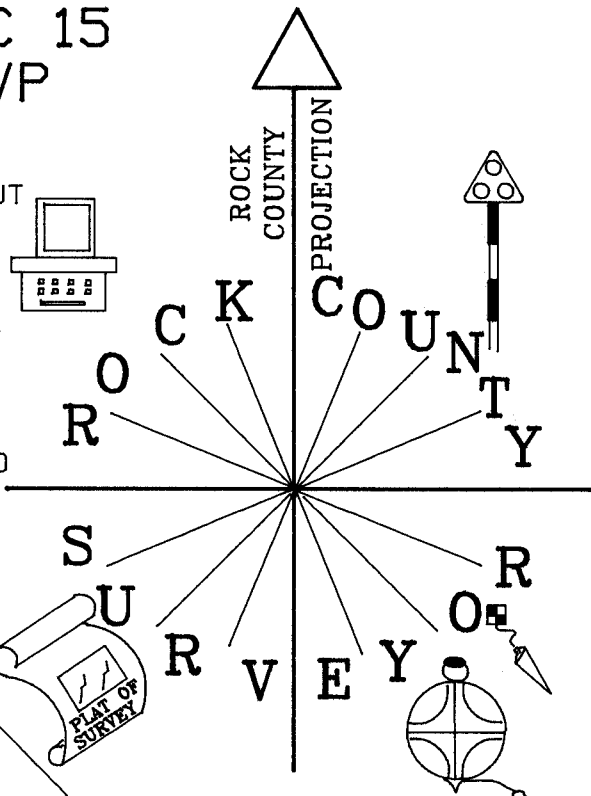

NOT TO SCALE

FD ALUM. 0.3' BELOW  
GRADE & 1.0' SOUTH OF E/W  
CENTER OF PVMT; 1.0' WEST  
OF N/S CENTER OF PVMT.  
REC TWP PROJECT 913.6  
PHOTO 912.5

● OLD WOOD FENCE POST  
OBSERVATION SHEET #547  
TIES - J-13  
VOL 5 PG 63

SET 3/4X24 REROD  
ELEV 914.5  
PHOTO 913

FD 1" PIPE  
ELEV 916.5  
PHOTO 914  
★ 12" DEAD  
TREE

