

# U. S. PUBLIC LAND SURVEY MONUMENT RECORD


For Public Land Survey Corners in the  
T. \_\_\_ N., R. \_\_\_ E.

## CORNER CODE INDEX

	1	2	3	4	5	6	7	8	9	10	11	12	13	14	15	16	17	18	19	20	21	22	23	24	25	
A																										
B																										
C	6																									
D		5																								
E			4																							
F				3																						
G					2																					
H																										
I																										
J																										
K																										
L																										
M																										
N																										
O																										
P																										
Q																										
R																										
S																										
T																										
U																										
V																										
W																										
X																										
Y																										
Z																										

PLACE MONUMENT SYMBOL (◆) AT PROPER  
LOCATION ON ABOVE INDEX

### EXAMPLE

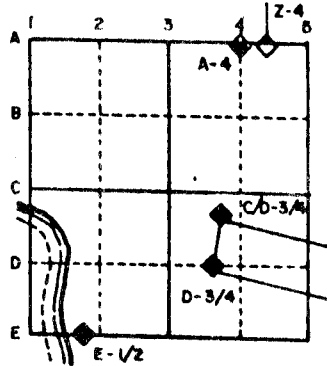

*HARMONY TWP*  
ROCK COUNTY WI

IF AVAILABLE  
STATE PLANE COORDINATES

North (Y) \_\_\_\_\_ Eleve. (Z) \_\_\_\_\_  
 East (X) \_\_\_\_\_ Zone \_\_\_\_\_  
 Hor. Datum \_\_\_\_\_ Vert. Datum \_\_\_\_\_

(a)  CORNER MONUMENT

WITNESS MONUMENT

BEARINGS ARE BASED ON:



FIELD BOOK \_\_\_\_\_ PAGE # \_\_\_\_\_

SHOW A PLAN VIEW DRAWING DEPICTING THE CORNER MONUMENT AND SURROUNDING PHYSICAL FEATURES, INCLUDING THE EXCAVATION AREA AND DEPTH. THE CORNER MONUMENT SHALL HAVE THE FOLLOWING CHARACTERISTICS: 1) HAVE AT LEAST TWO PREDETERMINED BREAK-OFF POINTS. 2) IF BROKEN, LEAVE A PERMANENTLY MAGNETIZED REMNANT AT THE ORIGINAL POINT. 3) MUST BE EXTENDABLE. 4) THE CAP IS INSCRIBED: ROCK COUNTY SURVEY MONUMENT - PENALTY FOR DISTURBING MARKER. 5) OR AN EXISTING CUT LIMESTONE. AN IRON PIPE 1 1/2" x 4'0" (MINIMUM) MAY BE USED IN AREAS WHERE GROUND WATER IS WITHIN ONE FOOT OF THE SURFACE. IF THE CORNER IS OCCUPIED BY AN IMPROVEMENT (MANHOLE, BURIED CABLE, ETC.) ANY DURABLE, DISTINCT MONUMENT MAY BE USED. CORNERS SHALL BE REFERENCED WITH AT LEAST 4 DURABLE WITNESS MONUMENTS. WITNESS MONUMENTS SHALL BE MADE OF CONCRETE, NATURAL STONE, IRON OR OTHER EQUALLY DURABLE MATERIAL, EXCEPT WOOD. DESCRIBE THE CORNER AND THE WITNESS MONUMENTS.

MICROFILMED

CORNER CODE:


R3(2)

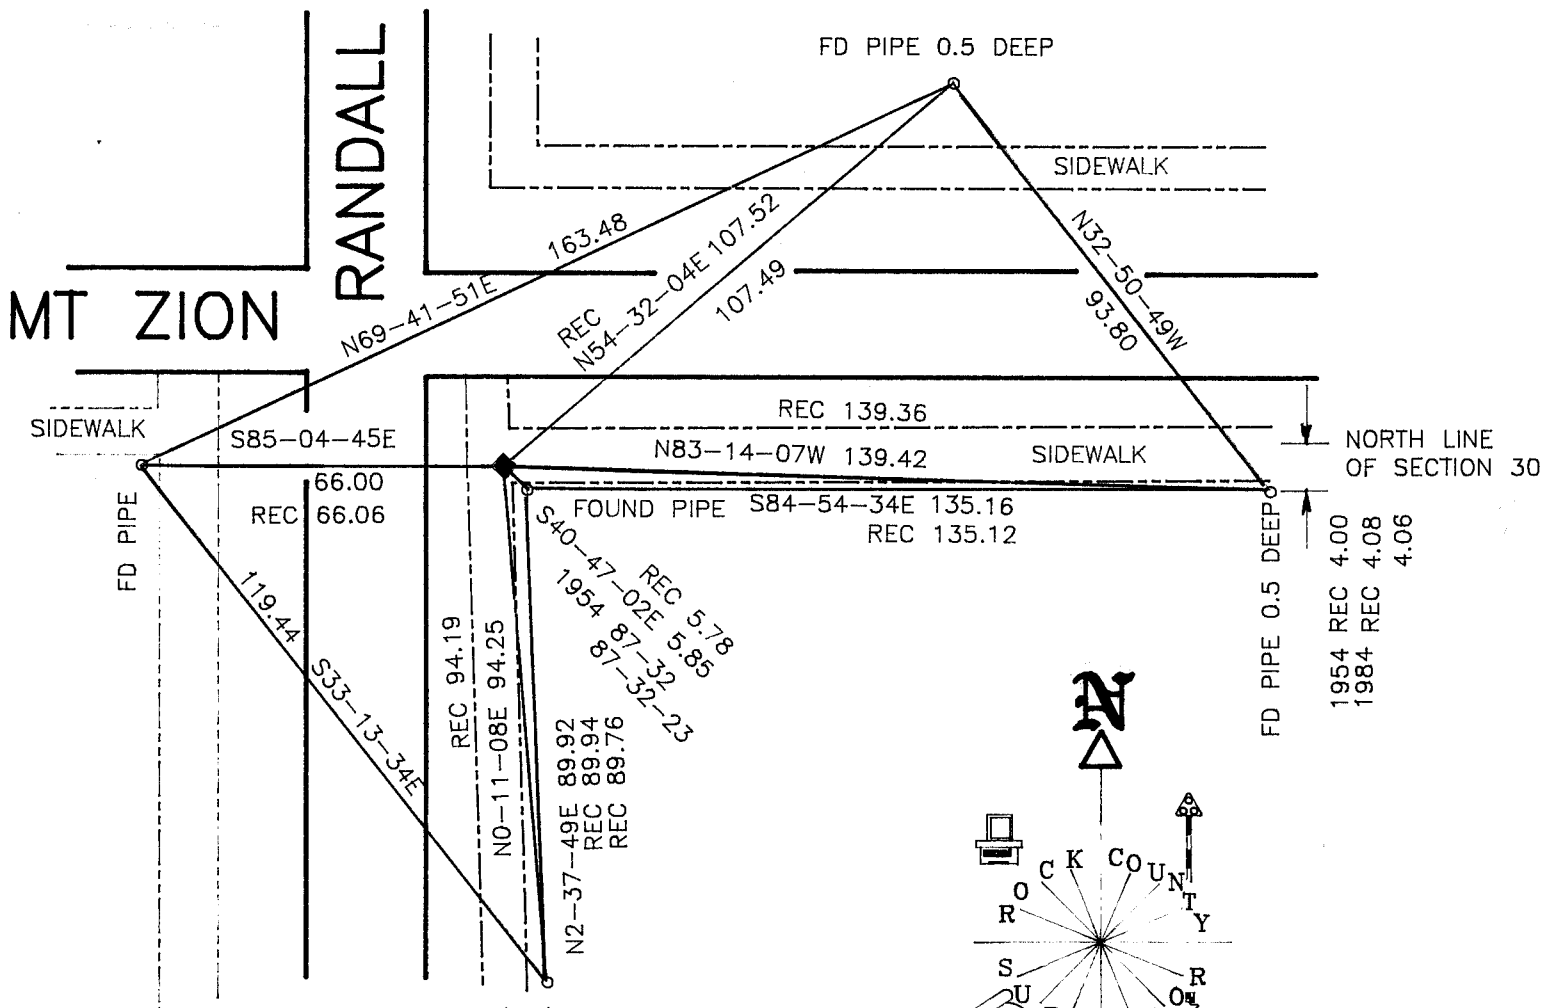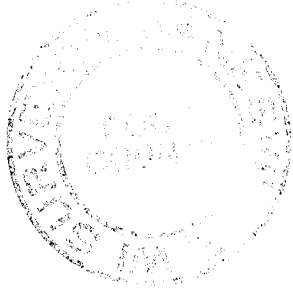

DRILL HOLE IN "U" OF DISTURB  
IN EASTERN PART OF BRASS DISK.

N/S LINE OF  
CENTER OF SECTION

1954 REC 4.00  
1984 REC 3.95  
4.01

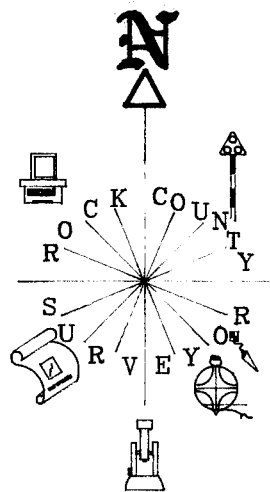

OBSERVATION SHEET #582

DISK STEM WAS REMOVED FOR INSTALLATION OF SIDEWALK RAMP.  
FOUND CUT LIMESTONE ABOUT 1' BELOW  
SIDEWALK GRADE. TOP PART OF MONUMENT WAS BROKEN OFF.  
PLACED MAGNETS ON SOUTH SIDE OF CUT  
LIMESTONE ABOUT 1.5' BELOW SIDEWALK GRADE.  
ELECTRIC LINE IN PIPE IS ABOUT 3" NORTH OF STONE.  
THE PIPE LAYS IN A NE/SW DIRECTION. PIPE  
IS ABOVE TOP GRADE OF STONE.

R3(2)