

U.S. PUBLIC LAND SURVEY MONUMENT RECORD

For Public Land Survey Corners in:

WI ADMINISTRATIVE CODE A-E 7.08 REQUIREMENT

T. 3N., R. 13E

CORNER CODE INDEX

A	2	3	4	5	6	7	8	9	10	11	12	13	14	15	16	17	18	19	20	21	22	23	24	25
B																								
C	6																							
D																								
E																								
F	1																							
G																								
H																								
I																								
J																								
K	18																							
L																								
M																								
N																								
O	19																							
P																								
Q																								
R																								
S	30																							
T																								
U																								
V																								
W																								
X	31																							
Y																								
Z																								

HARMONY TWP
ROCK COUNTY WI

IF AVAILABLE
ROCK COUNTY COORDINATES PREFERRED

North 79,882,807 m Elev. _____

East 684,861,322 m

Hor. Datum NAD 83 Vert. Datum _____

LATITUDE _____ ELLIPS. HT. _____

LONGITUDE _____

GPS (X) _____ TRAVERSE (X) _____


BASED ON THE FOLLOWING CONTROL:

PLACE MONUMENT SYMBOL \blacklozenge AT PROPER LOCATION ON ABOVE INDEX

\blacklozenge CORNER MONUMENT \circ WITNESS MONUMENT

BEARINGS ARE BASED ON:

LIMESTONE

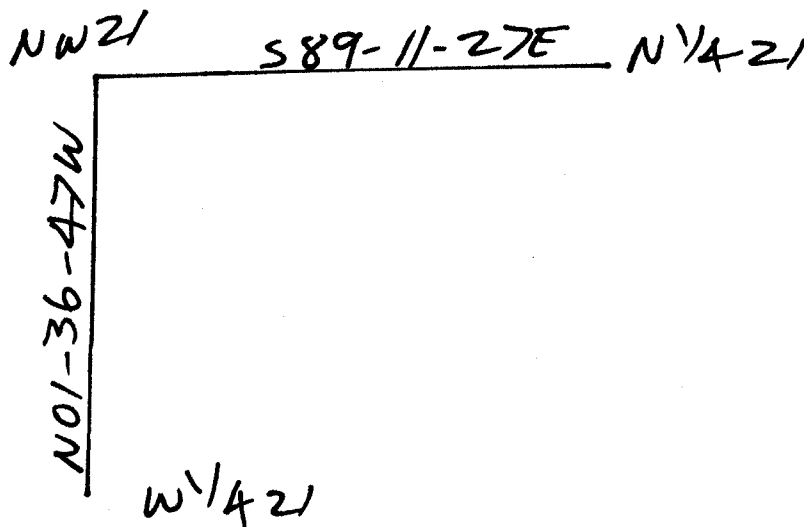

NOTE ON PLAT: COORDINATES & BEARINGS ON THIS PLAT ARE ORIENTED TO THE WI COORDINATE SYSTEM SOUTH ZONE, NAD 83. ALL PLAT DISTANCES ARE GROUND LENGTH AND MAY BE CONVERTED TO GRID LENGTH BY MULTIPLYING THE DISTANCE BY THE GRID FACTOR PROVIDED ON THE DETAIL SHEETS.

WIDOT PROJ. #5569-03-21 DATE: MAY 19 1995

Donald Barnes 263,082.18 FT
4-2-04 2,246,915.85

FIELD BOOK _____ PAGE # _____

SHEET 1 OF 1

SHOW A PLAN VIEW DRAWING DEPICTING THE CORNER MONUMENT AND SURROUNDING PHYSICAL FEATURES, INCLUDING THE EXCAVATION AREA AND DEPTH.

PLANNING & ZONING COMMITTEE ADOPTED THE ABOVE FORM ON 12/2/1982

CORNER CODE N 11 (1)

INFORMATION COPIED FROM WIDOT R/W PLATS. PROJECT NUMBER
AND DATE IS SHOWN ON OPPOSITE SIDE. WHEN COORDINATES WERE
SHOWN IN METERS I REDUCED TO U.S. SURVEY FEET. I REDUCED NAD
83 COORDINATES TO COUNTY COORDINATES.