
U.S. PUBLIC LAND SURVEY MONUMENT RECORD

For Public Land Survey Corners in:

WI ADMINISTRATIVE CODE A-E 7.08 REQUIREMENT

T. 3 N., R. 13 E

CORNER CODE INDEX

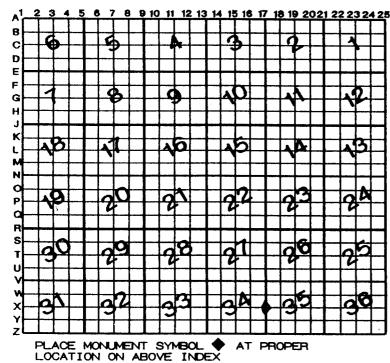

HARMONY		TWF
•	COUNTY	

IF AVAILABLE ROCK COUNTY COORDINATES PERFERRED

North	Elev
East	
Hor. Datum	Vert. Datum
LATITUDE .	ELLIPS. H
LONGITUTE	
GPS (X)	TRAVERSE (X)
BASED ON THE	FOLLOWING CONTROL:

♦CORNER MONUMENT

WITNESS MONUMENT

BEARINGS ARE BASED ON:

(a)

			الصفد	-7
FIELD BOOKPAGE #	S	HEET	1 1 1 1 1 1 1 1 1 1 1 1 1 1 1 1 1 1 1	OF Z
SHOW A PLAN VIEW DRAWING DEPICTING THE CORNER MONUMENT .	AND	SURRO	UNDING	
PHYSICAL FEATURES, INCLUDING THE EXCAVATION AREA AND DEPTH	1.			
PLANNING & ZONING COMMITTEE ADOPTED THE ABOVE FORM ON 12/2/1982				/)
				/ \

HA618

- (B)Describe any record evidence, monument evidence, occupational evidence, testimonial evidence or any other material evidence you considered, and whether the monument was found or placed.
- 1860 RUGER VOL 1 P.G 125 SET LIMESTONE ON END & SURROUNDED WITH 4 LIMESTONES. 2642.86' TO SW COR SEC 35, 2627.79' TO CENTER OF SEC 35, & 5253.6' TO E ¼ COR SEC 35
- 1860 RUGER VOL 1 PG 131 TOOK WITNESS STONES, LIMESTONE S40E 47.19' & LIMESTONE N40W 43.23', 2638.02' TO CENTER OF SEC 34, 5272.08' TO W 1/4 COR SEC 34.
- 1870 RUGER REMONUMENTATION FIELD NOTES PG 222. SOUTH ON EAST LINE OF NW ¼ SEC 34 ON A VAR 6-49 AT 2641.32' INTERSECTED ¼ LINE 3.96' WEST OF QUARTER COR. FOUND STONE ON COR. SET BY SELF. COR VAR 6-54 SOUTH ON EAST LINE OF SE ¼ SEC 34 ON A VAR 6-35 AT 2643.96' INTERSECTED SOUTH BOUNDARY LINE AT COR. FOUND LIME STONE ON COR. NOV 1 1870. (REMONUMENTATION PROJECT PLACED CUT LIMESTONES.)
- 1874 RUGER VOL 2 PG 135 STONE MON. 2640 VAR 5-00 TO CENTER SEC 35 & 2649.57' VAR 6-45 TO SW COR SEC 35.
- 1874 RUGER VOL 2 PG 136 CALLS FOR STONE MON.
- 1964 BATTERMAN VOL 4 PG 4. R.L. THOM FOUND CUT STONES AT THE NW, W ¼ & EAST ¼ CORNERS OF SEC 35. ESTABLISHED TIES WITH 1" PIPE.
- 1984 BARNES X-17 FOUND PK & 2' DEEP CUT STONE. SET POLY ON TOP OF STONE. FD NW REFERENCE PIPE & ESTABLISHED NE, SE, & SW REFERENCE MONUMENTS.

FOUND POLY MON. 0.2' DEEP & NE, SE, & NW REFERENCE MONUMENTS. MONUMENT WILL BE GROUND OUT & ROAD REPAVED.

C) Was the corner restored through acceptance of (1) an obliterated evidence location, or, (2) a found perpetuated location?

ACCEPTED FOUND MONUMENT.

- D) Describe any material discrepancy between the location of the corner as restored or reestablished and the location of that corner as previously restored or reestablished by distance and direction. Show the discrepancy on the plan view drawing under (a), above. Show the distances between the corner as previously restored or reestablished and (1) the corner as restored or reestablished, and (2) to at least 4 of the witness monuments shown on the drawing in (a), above.
- (E) Was the corner reestablished through lost corner proportionate methods? If so, show the method, including the directions and distances to other public land survey corners used as evidence or used for proportioning the corner location.
- I, Donald Barnes, hereby certify that the corner location as identified by the corner code index was determined by me under my direction and control and that this U.S. Public Land Survey Monument Record is correct and complete to the best of my knowledge and belief.

seal

Oct 25,2000

Number of included sheets 1

mboss

CORNER CODE X-17(1)

A-E 7.08 REQUIREMENT

