

U.S. PUBLIC LAND SURVEY MONUMENT RECORD

For Public Land Survey Corners in:
T. 3 N., R. 13 E

WI ADMINISTRATIVE CODE A-E 7.08 REQUIREMENT

CORNER CODE INDEX

A	1	2	3	4	5	6	7	8	9	10	11	12	13	14	15	16	17	18	19	20	21	22	23	24	25
B	6																								
C	7																								
D	8																								
E	9																								
F	10																								
G	11																								
H	12																								
I	13																								
J	14																								
K	15																								
L	16																								
M	17																								
N	18																								
O	19																								
P	20																								
Q	21																								
R	22																								
S	23																								
T	24																								
U	25																								
V	26																								
W	27																								
X	28																								
Y	29																								
Z	30																								

HARMONY TWP
ROCK COUNTY WI

IF AVAILABLE
ROCK COUNTY COORDINATES PREFERRED

North _____ Elev. _____

East _____

Hor. Datum _____ Vert. Datum _____

LATITUDE _____ ELLIPS. HT. _____

LONGITUDE _____

GPS (X) _____ TRAVERSE (X) _____

BASED ON THE FOLLOWING CONTROL:

PLACE MONUMENT SYMBOL  AT PROPER LOCATION ON ABOVE INDEX

 CORNER MONUMENT

WITNESS MONUMENT

(a)

BEARINGS ARE BASED ON:

FIELD BOOK _____ PAGE # _____

SHEET 1 / OF 2

SHOW A PLAN VIEW DRAWING DEPICTING THE CORNER MONUMENT AND SURROUNDING PHYSICAL FEATURES, INCLUDING THE EXCAVATION AREA AND DEPTH.

PLANNING & ZONING COMMITTEE ADOPTED THE ABOVE FORM ON 12/2/1982

CORNER CODE 8 Z-13(1)

(B) Describe any record evidence, monument evidence, occupational evidence, testimonial evidence or any other material evidence you considered, and whether the monument was found or placed.

FJ ALUM MON WITH TOP BROKE OFF

C) Was the corner restored through acceptance of (1) an obliterated evidence location, or, (2) a found perpetuated location?

ACCEPTED FOUND MON.

D) Describe any material discrepancy between the location of the corner as restored or reestablished and the location of that corner as previously restored or reestablished by distance and direction. Show the discrepancy on the plan view drawing under (a), above. Show the distances between the corner as previously restored or reestablished and (1) the corner as restored or reestablished, and (2) to at least 4 of the witness monuments shown on the drawing in (a), above.

(E) Was the corner reestablished through lost corner proportionate methods? If so, show the method, including the directions and distances to other public land survey corners used as evidence or used for proportioning the corner location.

I, DONALD BARNES, hereby certify that the corner location as identified by the corner code index was determined by me under by direction and control and that this U.S. Public Land Survey Monument Record is correct and complete to the best of my knowledge and belief.

Donald
seal

Barnes

4/11/02


emboss/stamped

Number of included sheets 1

CORNER CODE

A-E 7.08 REQUIREMENT

Z 13(1)

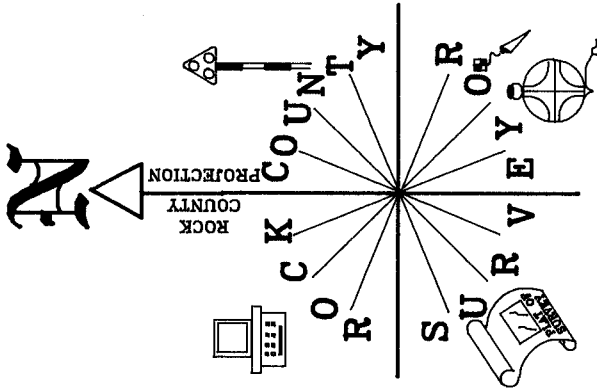

NOT TO SCALE

OBSERVATION SHEET #627
CORNER WILL BE
DISTURBED BY ROAD
CONSTRUCTION

E ELEVATION BASED ON
ASSUMED ELEVATION OF
100.00 FOR ALUM. MON.

□ FD ALUM. MON.
WITH TOP BROKE
OFF. 0.54'
BELOW P.V.M.T.
SET 2 MAGNETS

SE COR SEC 33
HARMONY TWP
NE COR SEC 4
LA PRAIRIE TWP

STH 14

E 1/4 COR
SEC 33
FD ALUM.
MON.

CABLE ANT
N15-59-17W 27.206 +/-

DRILL HOLE IN
TOP OF SUPPORT
BOLT OF LARGE
STEEL POWER
TOWER

N1-54-18E 325.28

E97.6
FD 3/4 PIN

SET 3/4X24
REROD /PLASTIC CAP
E95.94

S79-43-51E 122.76

S72-10-57E 242.05

S58-33-12E 235.14

STH 11

E100.9 FD BOLT

N82-24-38E 27.64

REC 27.60

FD WIDOT
PIN /PLASTIC CAP
MARKED 703
E101.0

N3-06-08E 45.03

N31-32-10E 57.04

N64-37-56E 110.47

N3-09-14E 895.44 +/-

N0-12-38W 2633.72

N3-09-14E 895.44 +/-

N3-09-14E 895.44 +/-

FD WIDOT PIN
/PLASTIC CAP
MARKED 264+99.96
E98.5
99.50

S88-58-56E 20.08

S88-56-51E 69.76

S88-56-51E 70.00

S88-56-51E 70.00

1/19/2012
DAB

229-53-26E
+/-
2366
CELL TOWER

Donald Frunes
EMBOSSED
SEAL

A-12-02

SHEET 2 OF 2

Z-13(1)