

U.S. PUBLIC LAND SURVEY MONUMENT RECORD

For Public Land Survey Corners in the


T. 3 N., R. 10 E

CORNER CODE INDEX

	1	2	3	4	5	6	7	8	9	10	11	12	13	14	15	16	17	18	19	20	21	22	23	24	25
A																									
B																									
C																									
D																									
E																									
F																									
G																									
H																									
I																									
J																									
K																									
L																									
M																									
N																									
O																									
P																									
Q																									
R																									
S																									
T																									
U																									
V																									
W																									
X																									
Y																									
Z																									

PLACE MONUMENT SYMBOL (◆) AT PROPER LOCATION ON ABOVE INDEX

EXAMPLE

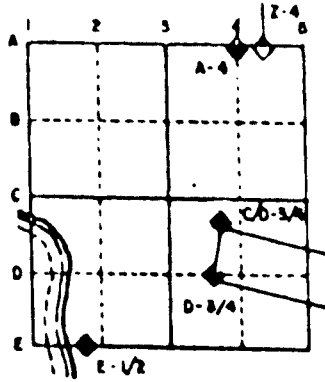

MAGNOLIA TWP
ROCK COUNTY WI

IF AVAILABLE
STATE PLANE COORDINATES

North (Y) 283,926.14 Eleve. (Z) _____
 East (X) 405,727.48 Zone _____
 Hor. Datum _____ Vert. Datum _____

◆ CORNER MONUMENT

○ WITNESS MONUMENT

COORDINATES ARE BASED ON THE ROCK COUNTY PROJECTION SYSTEM. ESTABLISHED BY CONVENTIONAL TRAVERSE FROM GPS "ALBANY" 304S AND THE AZIMUTH "ALBANY AZIMUTH" 304A WHICH IS IN THE SW 1/4 OF SECTION 7.



ma555

(B) Describe any record evidence, monument evidence, occupational evidence, testimonial evidence or any other material evidence you considered, and whether the monument was found or placed.

- 1855 CHURCH VOL 1 PG 56 FOUND STAKE BY STUMPS MARKED 1349.04 TO S 1/16TH COR OF NW 1/4 SEC 17.
- 1855 CHURCH VOL 1 PG 55 NO BT MADE CORNER WITNESS TO CORNER BR OAK 18 N18 1/2W 69, STONE SCHOOL HOUSE NW CORNERS S20 1/2 E 145. 2650.56 TO NE & SE CORNERS SEC 18.,
- 1870 RUGER VOL 2 PG 28 CORNER LOST & B. TREES DESTROYED IN WORKING ROAD. ESTABLISHED 1/4 COR FROM SECTION CORNERS. THEN MEASURED OFF & FOUND REMAINS OF STUMP OF ONE BT. SET IRREGULAR POINTED SANDSTONE 32X15X13 POINT UP. 2652.21 TO NE & SE CORNERS OF SEC 18.
- 1985 BARNES VOL 6 PG 343 2657.17 TO NE & SE CORNER OF SEC 18 & ON LINE. 2699.98 TO CENTER OF SEC 17.
- 1985 BARNES L-5 CALLS FOR 3/8" PIN & REFERENCED SAME. CALLS FOR A R/R TRAVERSE STATION & FB #2 PG 24,27,29.

FOUND ALUM. MON. & REFERENCE MONUMENTS.

C) Was the corner restored through acceptance of (1) an obliterated evidence location, or, (2) a found perpetuated location?
ACCEPTED FOUND MONUMENT.

D) Describe any material discrepancy between the location of the corner as restored or reestablished and the location of that corner as previously restored or reestablished by distance and direction. Show the discrepancy on the plan view drawing under (a), above. Show the distances between the corner as previously restored or reestablished and (1) the corner as restored or reestablished, and (2) to at least 4 of the witness monuments shown on the drawing in (a), above.

(E) Was the corner reestablished through lost corner proportionate methods? If so, show the method, including the directions and distances to other public land survey corners used as evidence or used for proportioning the corner location.

NO

I, Donald Barnes, hereby certify that the corner points as identified by the corner code index were, in a field survey on, APRIL 24, 1995, established, re-established, monumented, re-monumented, recovered or restored as expressed below and in conformance with the regulations and rules as required in the current manual of survey instructions of the United States Department of Interior, Bureau of Land Management.

seal

Donald Barnes
May 4 1995

EMBOSS LAND SURVEYOR SEAL

COUNTY SURVEYOR FILING DATA

Date of computer entry _____

Date microfilmed _____

Number of included sheets _____
CORNER CODE