

# U.S. PUBLIC LAND SURVEY MONUMENT RECORD

For Public Land Survey Corners in:

WI ADMINISTRATIVE CODE A-E 7.08 REQUIREMENT

T. 3 N., R. 13 E

### CORNER CODE INDEX

A	2	3	4	5	6	7	8	9	10	11	12	13	14	15	16	17	18	19	20	21	22	23	24	25
B	6																							
C	6																							
D																								
E																								
F																								
G	1																							
H		8									10										11			12
I																								
J																								
K																								
L	18																							
M																								
N																								
O																								
P	19																							
Q		20																						
R																								
S																								
T																								
U	30																							
V		29																						
W																								
X																								
Y																								
Z																								

HARMONY TWP

ROCK COUNTY WI

IF AVAILABLE  
ROCK COUNTY COORDINATES PREFERRED

North 81,555.093 M Elev. \_\_\_\_\_

<sup>S424</sup> East 681,592.735 M

Hor. Datum NAD83 Vert. Datum \_\_\_\_\_

LATITUDE \_\_\_\_\_ ELLIPS. HT. \_\_\_\_\_

LONGITUDE \_\_\_\_\_

GPS (X) \_\_\_\_\_ TRAVERSE (X) \_\_\_\_\_

BASED ON THE FOLLOWING CONTROL:

PLACE MONUMENT SYMBOL  $\blacklozenge$  AT PROPER LOCATION ON ABOVE INDEX


$\blacklozenge$  CORNER MONUMENT  $\circ$  WITNESS MONUMENT

(a) CUT LIMESTONE

NOTE ON PLAT: COORDINATES & BEARINGS ON THIS PLAT ARE ORIENTED TO THE WI COORDINATE SYSTEM SOUTH ZONE, NAD 83. ALL PLAT DISTANCES ARE GROUND LENGTH AND MAY BE CONVERTED TO GRID LENGTH BY MULTIPLYING THE DISTANCE BY THE GRID FACTOR PROVIDED ON THE DETAIL SHEETS.

WIDOT PROJ. #5569-03-21 DATE: MAY 19 1995

BEARINGS ARE BASED ON:

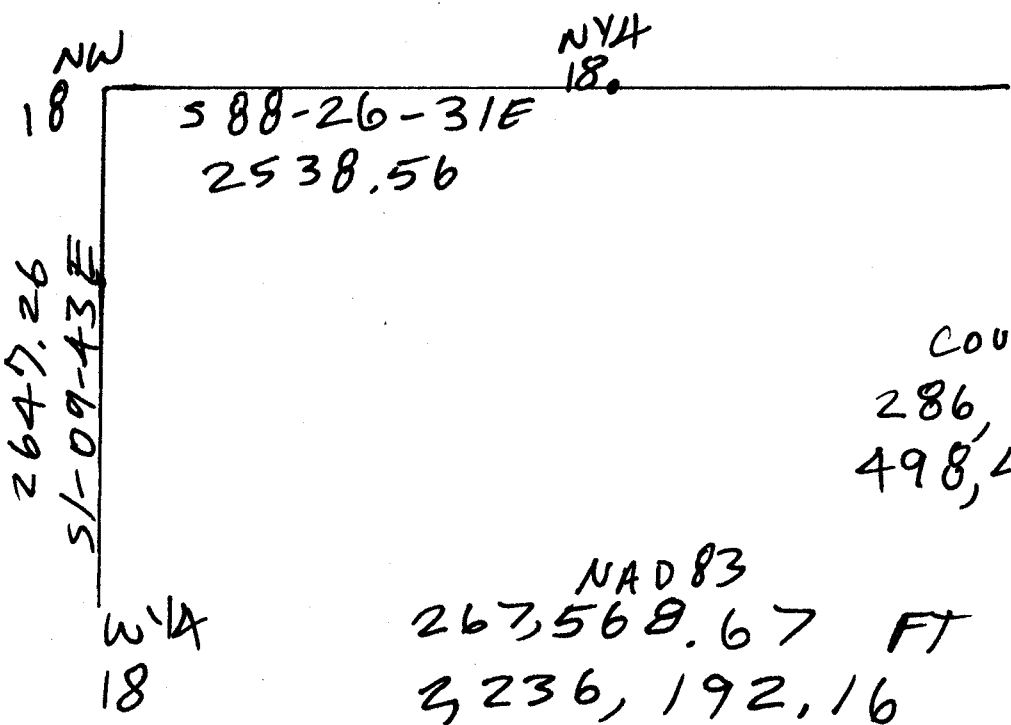

Dr. Banes  
4/02/04

FIELD BOOK \_\_\_\_\_ PAGE # \_\_\_\_\_

SHEET 1 OF 1

SHOW A PLAN VIEW DRAWING DEPICTING THE CORNER MONUMENT AND SURROUNDING PHYSICAL FEATURES, INCLUDING THE EXCAVATION AREA AND DEPTH.

PLANNING & ZONING COMMITTEE ADOPTED THE ABOVE FORM ON 12/2/1982

CORNER CODE J-3(1)

**INFORMATION COPIED FROM WIDOT R/W PLATS. PROJECT NUMBER  
AND DATE IS SHOWN ON OPPOSITE SIDE. WHEN COORDINATES WERE  
SHOWN IN METERS I REDUCED TO U.S. SURVEY FEET. I REDUCED NAD  
83 COORDINATES TO COUNTY COORDINATES.**