

Paper weight-110# (minimum)

Black nonfading ink required

# U.S. PUBLIC LAND SURVEY MONUMENT RECORD

For Public Land Survey Corners In:  
T. 3 N. R. 10 E. 4th P.M.

WI ADMINISTRATIVE CODE A-E 7.08 REQUIREMENT  
REV 10/23/2004 USMONREC.DWG

### CORNER CODE INDEX

MAGNOLIA TWP

ROCK COUNTY WI

IF AVAILABLE  
ROCK COUNTY COORDINATES PREFERRED

North \_\_\_\_\_ Elev. \_\_\_\_\_

East \_\_\_\_\_

Hor. Datum \_\_\_\_\_ Vert. Datum \_\_\_\_\_

LATITUDE \_\_\_\_\_ ELLIPS. HT. \_\_\_\_\_

LONGITUDE \_\_\_\_\_

NAD83(91) \_\_\_\_\_ NETWORK ADJ. YR \_\_\_\_\_

GPS (X) \_\_\_\_\_ TRAVERSE (X) \_\_\_\_\_

BASED ON THE FOLLOWING CONTROL:

	1	2	3	4	5	6	7	8	9	10	11	12	13	14	15	16	17	18	19	20	21	22	23	24	25		
A																											A
B																											B
C																											C
D																											D
E																											E
F																											F
G																											G
H																											H
J																											J
K																											K
L																											L
M																											M
N																											N
O																											O
P																											P
Q																											Q
R																											R
S																											S
T																											T
U																											U
V																											V
W																											W
X																											X
Y																											Y
Z																											Z

PLACE MONUMENT SYMBOL  AT PROPER LOCATION ON ABOVE INDEX

CORNER MONUMENT

WITNESS MONUMENT

BEARINGS ARE BASED ON: \_\_\_\_\_

FIELD BOOK \_\_\_\_\_ PAGE # \_\_\_\_\_

SHEET 1 OF 3

SHOW A PLAN VIEW DRAWING DEPICTING THE CORNER MONUMENT AND SURROUNDING PHYSICAL FEATURES, INCLUDING THE EXCAVATION AREA AND DEPTH.

PLANNING & ZONING COMMITTEE ADOPTED THIS FORM ON 12/2/1982

CORNER CODE V-1(z)

MA601

(B) Describe any record evidence, monument evidence, occupational evidence, testimonial evidence or any other material evidence you considered, and whether the monument was found or placed.

1833 MULLETT & BRINK PG 14 SEP

VAR B-35E

WEST ON SOUTH SIDE SECTION 36

1980 ENTER MARSH  
2376 STREAM 3.96' @ SW  
2640 SET 1/4 SECTION POST  
ASPEN 14 N11 1/2W 36.3' BURR OAK 16 N89  
1/2E 801.24'  
4422 LEAVE MARSH  
5280 SET POST CORNER SECTIONS 35 & 36. BUR OAK  
16 N89 1/2 W 357.72'; BUR OAK 16 N87 1/2E  
225.06'  
LAND ROLLING, 1<sup>ST</sup> HALF SECOND RATE. LAST  
1/2 WET, TIMBER ASPEN, WILLOW, OAK,

1833 MULLETT & BRINK SEP 6<sup>TH</sup> PG 12 NORTH ON EAST SIDE  
OF SEC 1 T2N R9E

462 STREAM 5.28' @ SW  
2640 SET 1/4 SECTION POST BUR OAK 16 N38 1/2 W  
84.48', NO OTHER  
5138.10 INTERSECTED SOUTH BOUNDARY OF T3N RUN  
OUT FROM POST ON RIGHT BANK OF SUGAR  
CREEK. SET POST AT INTERSECTION FOR  
CORNER TO TOWNSHIPS 2 & 3 NORTH RANGE 9  
EAST. LAND ROLLING, SECOND RATE TIMBER  
BUR OAK. SEPTEMBER 6<sup>TH</sup> 1833

1833 MULLETT & BRINK SEP 3<sup>RD</sup> PG 18 VAR B-35E

NORTH ON EAST SIDE SEC 36 T3N 9E

1100.88 BUR OAK 10  
2640 SET 1/4 SEC POST B OAK 18 52.14'  
B. OAK 7 11.22'  
3020.82 B. OAK 14  
3828.0 SUMMIT OF A HILL NW & SE  
4793.58 BUR OAK 24  
5280 SET POST COR SECTIONS 25 & 36 BUR OAK 7  
N20W 10.56' BUR OAK 12 S54W 31.02'  
LAND ROLLING, SECOND RATE TIMBER BUR &  
BLACK OAK

1833 HARRISON DEC BETW SECS 30 & 31

730.62 WD 30 IN DIAM  
2640 QUARTER SEC COR {BURR O 18 N28W 17.16'  
BURR O 12 S41W 66' BURR O 18} MARKED  
BURR O 12} MARKED  
5334.12 INT W BDY 1081.08' NORTH OF COR TO TOWNS  
2 & 3 & OF RG 9 & 10 {W.O. 14 N82E 33' RED  
OAK 12 S50E 46.2'  
LAND ? & SAME

1859 HIGHWAY RECORDS BOOK 1 PG 22 STATES THAT THE  
DISTANCE FROM THE SW CORNER OF SECTION 31 TO THE  
NE CORNER OF SECTION 1 T2N R9E IS 4438.50. THE  
MEASURED DISTANCE IS 4134.76.

1860 HIGHWAY RECORDS BOOK 1 PG 26

"" FOR THE LAYING OUT OF A HIGHWAY DESCRIBED AS  
FOLLOWS: COMMENCING AT THE NORTH EAST CORNER OF  
THE TOWN OF DECATUR RUNNING THENCE NORTH TO THE  
NORTH WEST CORNER OF SECTION 31 IN THE TOWN OF  
MAGNOLIA ON THE WEST LINE OF SAID SECTION THE SAID  
HIGHWAY TO RUN ON THE TOWN LINE BETWEEN THE TOWN

SHEET 1 OF 3

CORNER CODE V-1(2)

Donald Bance

OCT 25, 2007

MA601

OF ALBANY IN THE COUNTY OF GREEN THE LINE TO BE THE SURVEY OF SAID HIGHWAY AND THE SAME IS ESTABLISHED FOUR RODS. JULY

1873 LEE VOL 2 PG 96 FOUND W.O. B.T. & STUMP OF RED O B.T. DID NOT STATE WHAT HE PLACED.

1937 SUNNY VOL 3 PG 344 DUG 5X54 DEEP HOLE & FOUND NOTHING.

1987 BARNES V-1 DID NOT RE-EXCAVATE FOR CORNER. DECLARED CORNER LOST & PLACED POLY MONUMENT. 1081.08 TO NE CORNER SEC 1 & 1539.76 TO E 1/4 COR SEC 36.

1996 BARNES V-1(1) FOUND POLY. MONUMENT & REFERENCED SAME. MONUMENT WILL BE DISTURBED BY PAVING PROJECT.

FD REFERENCE TIES. THE UTILITY POLES IN THE NE SIDE OF THE RD INTERSECTION WERE REPLACED, WHICH DISTURBED THE REFERENCE MONUMENTS.

*C) Was the corner restored through acceptance of (1) an obliterated evidence location, or, (2) a found perpetuated location?*

**ACCEPED FD PERPETUATED LOCATION.**

*D) Describe any material discrepancy between the location of the corner as restored or reestablished and the location of that corner as previously restored or reestablished by distance and direction. Show the discrepancy on the plan view drawing under (a), above. Show the distances between the corner as previously restored or reestablished and (1) the corner as restored or reestablished, and (2) to at least 4 of the witness monuments shown on the drawing in (a), above.*

*(E) Was the corner reestablished through lost corner proportionate methods? If so, show the method, including the directions and distances to other public land survey corners used as evidence or used for proportioning the corner location.*

I, **DONALD BARNES**, hereby certify that the corner location as identified by the corner code index was determined by me under my direction and control and that this U.S. Public Land Survey Monument Record is correct and complete to the best of my knowledge and belief.

Seal

SHEET 2 OF 3

*Donald Barnes*

*Oct 25, 2007*

CORNER CODE

**V-1(2)**

A-E 7.08 REQUIREMENT

STH 104

1V16  
PID DF9796  
WIDOT DISK  
IN CONC.  
ELEV 830.26

SW COR  
SEC 30  
MAGNOLIA TWP  
T3N R10E

N02-07-12W 29.20  
1996 N02-15-09W 29.20  
1987 N2-14-32W 29.19  
ELEV 830.4

ELEV 835.0  
1987 S88-20-26E 49.34  
1996 S88-21-51E 49.34  
S88-13-15E 49.34

N00-23-03E 114.05  
1996 N00-15-12E 114.05  
1987 N00-15-33E 114.05  
N23-59-34E 123.17  
1987 N23-51-42E 123.17  
1996 N23-52-07E 123.15

SHEET 3 OF 3  
V-1(2)

FD REROD BENT  
TO THE NW

1996 N41-15-42E 161.52  
POLY. WITH TOP BROKE OFF  
1996 N20-14-35E 162.01  
1987 76.26 REC PK  
1987 47.40  
1996 N66-36-23E 153.54  
1996 N66-36-23E 153.90  
1996 N66-36-23E 153.90

NEW UP


NEW UP  
FD REROD SLIGHTLY  
BENT TO THE SW  
ELEV 828.23

CTH B

- FD POLY. MON. WITH TOP BROKE OFF
- FD DOT DISK IN CONCRETE
- FD 3/8 REROD
- 3/4X24 REROD
- SMALL DURA NAIL

LARGE TREE

1996 N21-47-56E 160.79  
1996 N21-51-06E 160.52  
S30-49-44E 77.02  
1987 N42-45-22W 120.09  
1996 S42-45-22E 120.11  
S42-37-10E 120.11  
ELEV 834.7  
1987 N79-27-33E 133.62  
1996 N79-27-18E 133.61  
1996 N79-35-30E 133.61  
ELEV 848.9

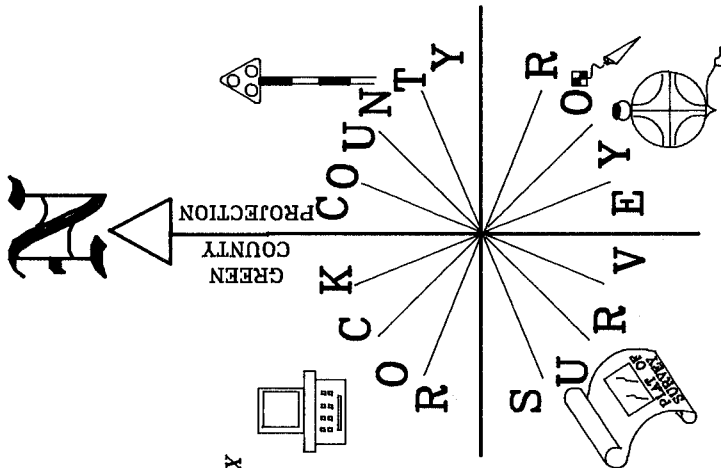

NOT TO SCALE  
OBSERVATION SHEET #65  
FB #3 PC 27 & 31  
ELEV BASED ON 1V16

*David Barnes*

EMBOSSED SEAL

OCT 25, 2007