

U.S. PUBLIC LAND SURVEY MONUMENT RECORD

For Public Land Survey Corners In:

WI ADMINISTRATIVE CODE A-E 7.08 REQUIREMENT

T. 3 N. - R. 10 E. of the 4th P.M.

CORNER CODE INDEX

(PLACE "◆" SYMBOL AT PROPER PLSS CORNER LOCATION)

	1	2	3	4	5	6	7	8	9	10	11	12	13	14	15	16	17	18	19	20	21	22	23	24	25	
A																										
B																										
C	6																									
D																										
E																										
F																										
G	7																									
H																										
J																										
K																										
L	18																									
M																										
N																										
O																										
P	19																									
Q																										
R																										
S																										
T	30																									
U																										
V																										
W																										
X	31																									
Y																										
Z																										
	1	2	3	4	5	6	7	8	9	10	11	12	13	14	15	16	17	18	19	20	21	22	23	24	25	

MAGNOLIA TWP
ROCK COUNTY WI

COORDINATES

(GNSS DERIVED VIA WISCORS)

NORTHING: 270522.42 ELEV: N/A

EASTING: 427187.41

Hor. Datum: WCCS-ROCK, (NA2011)



Vertical Datum: NAVD 88, (If applicable)

(a) LEGEND

- ⊙ - CAPPED IRON REBAR FOUND
- ⊙ - IRON PIPE FOUND
- ⊙ - DRILL HOLE SET IN BOX CULVERT
(Centered, +/-, on exposed 6" top)
- (#) - PREVIOUS TIE-SHEET DIMENSION



- COTTON GIN SPINDLE SET

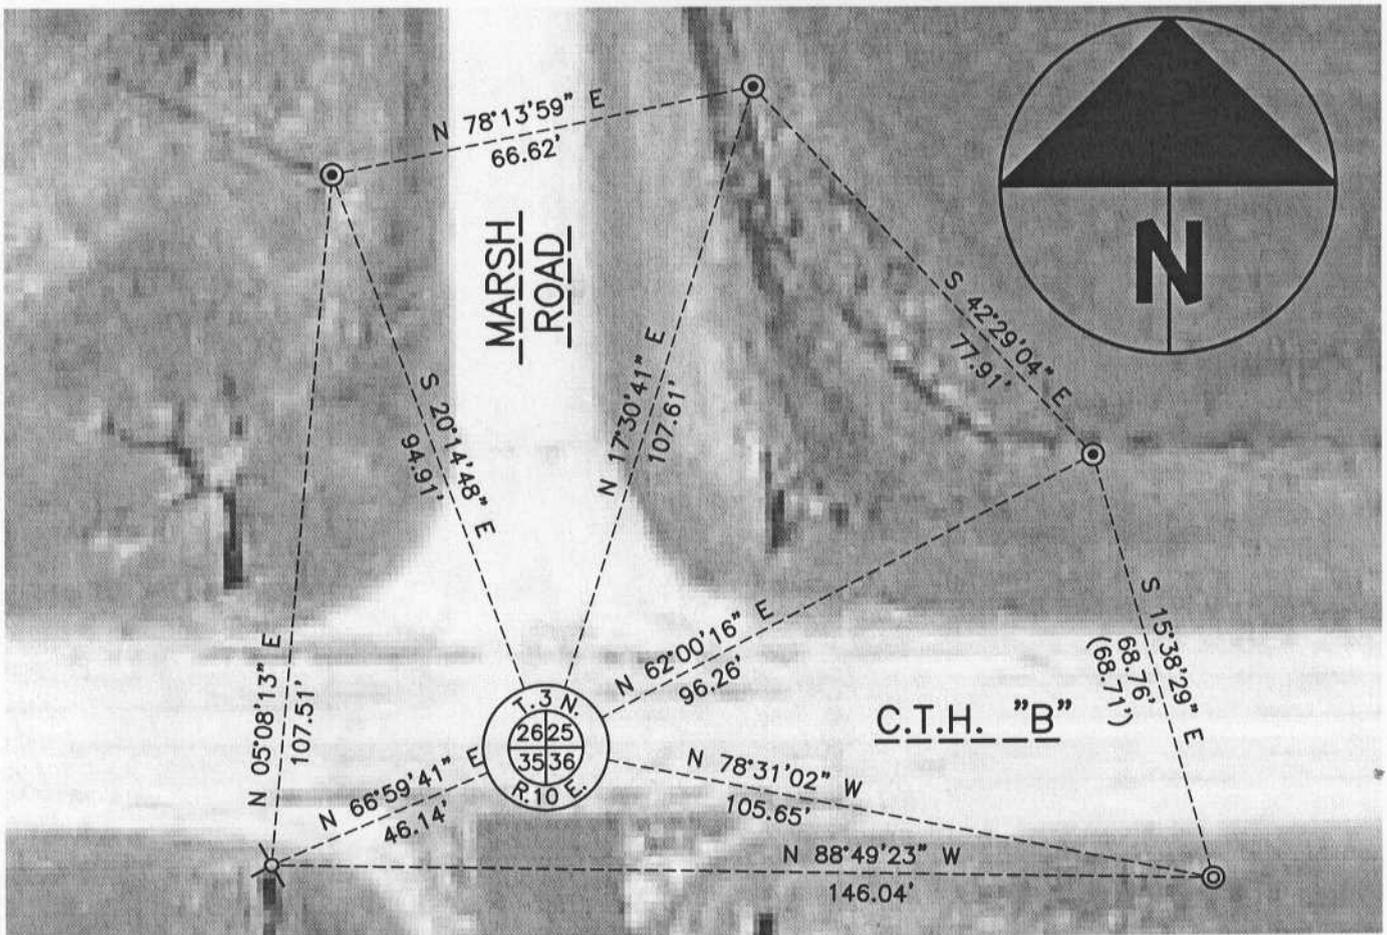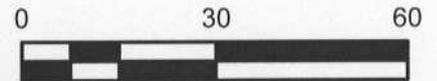

Field book: Magnolia 2013-14

Page: 60

Page 1 of 2

Corner code: V-21

B) Describe any record evidence, monument evidence, occupational evidence, testimonial evidence or any other material evidence you considered, and whether the monument was found or placed.

I found four witnesses from the 2004 V-21 monument record, (Barnes), and accepted all. From two ties I computed the PLSS corner position by distance/distance intersection, (distances of 94.91 & 96.26 feet), and set a cotton gin spindle; the other witnesses check within expected tolerances and I set a fifth witness, (drill hole), in the top of a concrete box culvert. The Barnes tie-sheet indicates he set a 1/2" x 9" rod inside of a found pipe below the surface. The rod was found bent over and an asphalt patch exists at the corner location.

I did not excavate the patch as it is approximately 1 foot square and the found pipe is 0.8 feet below the surface inside of a monument box without a lid. Given the proximity of witnesses and durability of the asphalt patch, I chose to not create additional maintenance issues.

C) Was the corner restored through acceptance of (1) an obliterated evidence location, or, (2) a found perpetuated location?

Found perpetuated location.

D) Describe any material discrepancy between the location of the corner as restored or reestablished and the location of that corner as previously restored or reestablished by distance and direction. Show the discrepancy on the plan view drawing under (a), above. Show the distances between the corner as previously restored or reestablished and (1) the corner as restored or reestablished, and (2) to at least 4 of the witness monuments shown on the drawing in (a), above.

I did not find a discrepancy between the corner restored and a previously documented corner location. *Discrepancy* being defined as *disagreeing* with a corner location, *not* as noting dimensional differences between current/former tie sheets due to measuring methods. The current and *most recent* tie-sheet dimensions filed for the corner are noted.

(E) Was the corner reestablished through lost corner proportionate methods? If so, show the method, including the directions and distances to other public land survey corners used as evidence or used for proportioning the corner location.

N/A

I, **Jason R. Houle**, hereby certify that the corner location as identified by the corner code index was determined by me under my direction and control and that this U.S. Public Land Survey Monument Record is correct and complete to the best of my knowledge and belief.

CORNER CODE: V-21
(A.E. 7.08 REQUIREMENT)

