PUBLIC LAND U.S. SURVEY


MONUMENT RECORD

For Public Land Survey Corners in:

WI ADMINISTRATIVE CODE A-E 7.08 REQUIREMENT

T. 3 N., R. 40 E

CORNER CODE INDEX

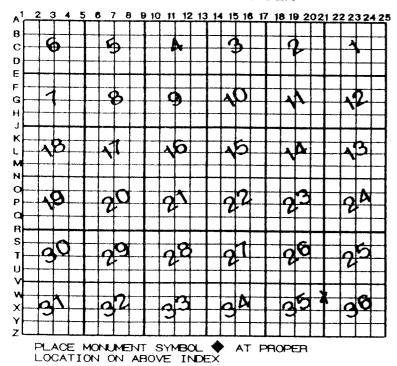

MAGA	JOHA	TWI
ROCK	COUNTY	wı

IF AVAILABLE ROCK COUNTY COORDINATES PERFERRED

North	-		EI	ev.		_
East						
Hor. I	Datui	m	Vert. E	atu	m	
LATIT	UDE	_			ELLIPS.	H
LONG	TUT	Έ _			· · · · · · · · · · · · · · · · · · ·	
GPS	(x)		TRAVER	SE	(X)	
BASED	ON	THE	FOLLOWING	CC	NTROL:	

♦CORNER MONUMENT

WITNESS MONUMENT

BEAFINGS ARE BASED ON

(a)

FIELD BOOK	PAGE #	SHEET $ \bot $ OF $ 3 $
SHOW A PLAN VIEW PHYSICAL FEATURES	DRAWING DEPICTING THE CORNER MONUME	NT AND SURROUNDING

PLANNING & ZONING COMMITTEE ADOPTED THE ABOVE FORM ON 12/2/1982

MA2611 1/16TH COR

- (B) Describe any record evidence, monument evidence, occupational evidence, testimonial evidence or any other material evidence you considered, and whether the monument was found or placed.
- 1881 LEE VOL 2 PG 335 DROVE OAK STAKE SURROUNDED BY 4 LIME STONES. 1329.24 TO NE COR & E 1/4 COR SEC 35
- 1967 BATTERMAN VOL 4 PG 303 DUG AND FOUND REMAINS OF WOOD STAKE WITH L.S. ON N & E. OTHER STONES GONE. SET 1" PIPE IN STAKE HOLE & REFERENCED SAME. 1329+/_ TO NE COR SEC 35 & 1329+/_ TO E 1/4 COR SEC 35
- 1967 BATTERMAN VOL 4 PG 336 HC. TN. SET PIK NAIL IN 1967. FD REF.
- 1988 BARNES VOL 6 PG 390 N1-08-34W 1327.14 TO NE COR SEC 35, S0-55-27E? 1330.95 TO E $\frac{1}{4}$ COR SEC 35, & ANGLE 91-07-34 @ NE COR SEC 35 FROM $\frac{1}{16}$ COR TO N $\frac{1}{4}$ COR SEC 35
- 1988 BARNES FB#4 PG 1 & 8 FD PK.
- 1988 BARNES W-21 FD PK THAT AGREED WITH TIES TO THE BRIDGE.
 ACCEPTED FOUND PERPETUATED LOCATION. COORDINATES
 249,762.20; 2,196,710.70
- 1996 LATHROP #9082 2658.30 FROM NE TO E $\frac{1}{4}$ COR SEC 35

BRIDGE WILL BE DESTROYED. DID NOT FIND PK. USED THE FD PIPE AND TIES TO BRIDGE TO ESTABLISH THE POSITION. I COULD NOT FIND A RECORD OF WHO OR HOW THE OLD PK WAS PLACED.

C) Was the corner restored through acceptance of (1) an obliterated evidence location, or, (2) a found perpetuated location?

ACCEPTED PERPETUATED LOCATION.

- D) Describe any material discrepancy between the location of the corner as restored or reestablished and the location of that corner as previously restored or reestablished by distance and direction. Show the discrepancy on the plan view drawing under (a), above. Show the distances between the corner as previously restored or reestablished and (1) the corner as restored or reestablished, and (2) to at least 4 of the witness monuments shown on the drawing in (a), above.
- (E) Was the corner reestablished through lost corner proportionate methods? If so, show the method, including the directions and distances to other public land survey corners used as evidence or used for proportioning the corner location.
- I, **Donald Barnes**, hereby certify that the corner location as identified by the corner code index was determined by me under my direction and control and that this U.S. Public Land Survey Monument Record is correct and complete to the best of my knowledge and belief.

SHEET 1 OF 3

6-9-04

CORNER CODE W-21(1)

A.E. 7.08 REQUIREMENT

