
U.S.

PUBLIC LAND SURVEY MONUMENT RECORD

For Public Land Survey Corners in: T. 2N., R. 6

WI ADMINISTRATIVE CODE A-E 7.08 REQUIREMENT

CORNER CODE INDEX

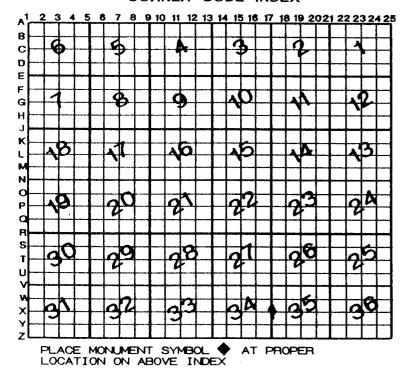

MAGI	TWP	
ROCK	COUNTY	wı

IF AVAILABLE
ROCK COUNTY COORDINATES PERFERRED

North	Elev
East	***************************************
Hor. Datum _	Vert. Datum
LATITUDE	ELLIPS. H
LONGITUTE	
GPS (X)	TRAVERSE (X)
BASED ON THE	FOLLOWING CONTROL:

◆CORNER MONUMENT

O WITNESS MONUMENT

BEARINGS ARE BASED ON:

(a)

		OF	Z
FIELD BOOKPAGE #	SHEET _	(_ OF	
SHOW A PLAN VIEW DRAWING DEPICTING THE CORNER MONUMENT AND	SURROU	NDING	
PHYSICAL FEATURES, INCLUDING THE EXCAVATION AREA AND DEPTH.			
PLANNING & ZONING COMMITTEE ADOPTED THE ABOVE FORM ON 12/2/1982			

MA618

- (b) Describe any record evidence, monument evidence, occupational evidence, testimonial evidence or any other material evidence you considered, and whether the monument was found or placed.
- 1858 CHURCH VOL 1 PG 84 USED TO SUBDIVIDE SECTION 35. NO COMMENTS ABOUT CORNER. 2571.36 TO CENTER 35 & 5142.72 TO E 1/4 COR SEC 35.
- 1874 RUGER VOL 2 PG 134 USED TO SUBDIVIDE SECTION 34. FOUND OLD STAKE DEEP IN GROUND & REDISH HH STONE 17x15x11 ON TOP OF STAKE.
- 1929 BATTERMAN VOL 3 PG 163 FOUND RUGERS STAKE & STONE & REFERENCED SAME.
- 1932 SUNNY VOL 3 PG 151 RESET MONUMENT IN CONCRETE PAVEMENT WITH 1X36 PIPE FLUSH WITH PAVEMENT. NOTE: THIS CORNER WAS REFERENCED BY BATTERMAN PREPARATORY TO PAVING HIGHWAY & RESET BY ME. REFERENCED SAME. COR 5.5 WEST OF CENTER PVMT.
- 1967 BATTERMAN VOL 3 PG 163 FOUND A 1/2 PIPE IN CONCRETE PAVEMENT & REFERENCED SAME.
- 1967 BATTERMAN VOL 4 PG 336 FOUND 1 PIPE IN CONCRETE PAVEMENT & REFERENCED SAME, SEE PAGE 489
- 1970 BATTERMAN VOL 4 PG 489 FOUND 1 1/2" PIPE IN CONCRETE PAVEMENT & REFERENCED SAME. 5.7' WEST OF CENTER PVMT.
- 1985 WI X-17(1) D.O.T FIELD SURVEY NOTES FORM. REFERENCE TIES.
- 1988 BARNES X-17 FOUND D.O.T. CAPPED RODS WITH SIGNS. ALSO FOUND OLD REFERENCE PIPES. ESTABLISHED CORNER AT LOCATION THAT WOULD FIT ALL THE REFERENCE PIPES THE BEST. CORNER 5' WEST OF CENTER OF PVMT.

FD PK 5.7 WEST OF CENTER OF PVMT. & REFERENCE PIPES. PK WAS IN HARMONY WITH REFERENCE MONUMENTS.

(c) Was the corner restored through acceptance of (1) an obliterated evidence location, or, (2) a found perpetuated location?

I ACCEPTED OBLITERATED EVIDENCE LOCATION.

- D) Describe any material discrepancy between the location of the corner as restored or reestablished and the location of that corner as previously restored or reestablished by distance and direction. Show the discrepancy on the plan view drawing under (a), above. Show the distances between the corner as previously restored or reestablished and (1) the corner as restored or reestablished, and (2) to at least 4 of the witness monuments shown on the drawing in (a), above.
- (E) Was the corner reestablished through lost corner proportionate methods? If so, show the method, including the directions and distances to other public land survey corners used as evidence or used for proportioning the corner location.
- I, **Donald Barnes**, hereby certify that the corner location as identified by the corner code index was determined by me under my direction and control and that this U.S. Public Land Survey Monument Record is correct and complete to the best of my knowledge and belief.

Seal

Vinal Shaires
Emboss
May 15,2000

Number of included sheets 1

CORNER CODE X-17(3)

