

U.S. PUBLIC LAND SURVEY MONUMENT RECORD

For Public Land Survey Corners in:

WI ADMINISTRATIVE CODE A-E 7.08 REQUIREMENT

T. 3N., R. 13E

CORNER CODE INDEX

HARMONY TWP

ROCK COUNTY WI

IF AVAILABLE
ROCK COUNTY COORDINATES PREFERRED

A	1	2	3	4	5	6	7	8	9	10	11	12	13	14	15	16	17	18	19	20	21	22	23	24	25
B	6					5				4					3					2					1
C																									
D																									
E																									
F																									
G	1					8				9					10					11				12	
H																									
J																									
K																									
L	18					11				16					15					14				13	
M																									
N																									
O																									
P	19					20				21					22					23				24	
Q																									
R																									
S	30					29				28					27					26				25	
T																									
U																									
V																									
W	31					32				33					34					35				36	
X																									
Y																									
Z																									

PLACE MONUMENT SYMBOL AT PROPER LOCATION ON ABOVE INDEX

North _____ Elev. _____

East _____

Hor. Datum _____ Vert. Datum _____

LATITUDE _____ ELLIPS. HT. _____

LONGITUDE _____

GPS (X) _____ TRAVERSE (X) _____

BASED ON THE FOLLOWING CONTROL:

CORNER MONUMENT

WITNESS MONUMENT

(a)

BEARINGS ARE BASED ON:

FIELD BOOK _____ PAGE # _____

SHEET 1 OF 2

SHOW A PLAN VIEW DRAWING DEPICTING THE CORNER MONUMENT AND SURROUNDING PHYSICAL FEATURES, INCLUDING THE EXCAVATION AREA AND DEPTH.

PLANNING & ZONING COMMITTEE ADOPTED THE ABOVE FORM ON 12/2/1982

CORNER CODE X21(1)

HA619

(B) Describe any record evidence, monument evidence, occupational evidence, testimonial evidence or any other material evidence you considered, and whether the monument was found or placed.

- 1860 RUGER VOL 1 PG 125 STATES NOTHING ABOUT MONUMENT. USED TO SUBDIVIDE SEC 35. 2625.81' TO CENTER OF SEC 35 & 5253.6' TO W ¼ COR SEC 35.
- 1860 RUGER VOL 1 PG 135 SET WHITE BRICK. 2645.28' TO SW COR SEC 36 VAR 8-10
- 1870 RUGER REMONUMENTATION NOTES PG 225. SOUTH ON WEST LINE OF N.W. QUARTER SEC 36 ON A VAR 7-25 AT 2634.39' INTERSECTED QUARTER LINE 1.98' EAST OF ¼ COR. FOUND LIMESTONE ON COR. SET BY SELF. CORR. VAR 7-22. SOUTH ON WEST LINE OF S.W. QUARTER SEC 36 ON A VAR 7-15 AT 2626.31' INTERSECTED SOUTH BOUNDARY LINE AT COR. (REMONUMENTATION PLACED CUT LIMESTONES.)
- 1874 RUGER VOL 2 PG 135 STONE MON. VAR 5-00 TO W ¼ COR SEC 35.
- 1964 BATTERMAN. VOL 4 PG 4 ESTABLISHED TIES. R.L. THOM FOUND CUT STONES AT THE N.W COR, W ¼ COR, & E ¼ COR OF SEC 35.
- 197? SCHROEDER VOL 5 PG 63 SHOWS TIES BUT STATES NOTHING ABOUT CORNER.
- 1984 BARNES X17. ESTABLISHED TIES. FOUND PK & 2' DEEP FOUND CUT LIMESTONE. SET POLY ON TOP OF STONE.

FOUND POLY. MON. 0.1' DEEP @ CENTER OF E/W PVMT & 1' WEST OF CENTER OF PAVEMENT PROJECTED FROM NORTH. PAVEMENT WILL BE GROUND & PAVED. FOUND 4 REFERENCE TIE MONUMENTS.

C) Was the corner restored through acceptance of (1) an obliterated evidence location, or, (2) a found perpetuated location?

ACCEPTED FOUND MONUMENT.

D) Describe any material discrepancy between the location of the corner as restored or reestablished and the location of that corner as previously restored or reestablished by distance and direction. Show the discrepancy on the plan view drawing under (a), above. Show the distances between the corner as previously restored or reestablished and (1) the corner as restored or reestablished, and (2) to at least 4 of the witness monuments shown on the drawing in (a), above.

(E) Was the corner reestablished through lost corner proportionate methods? If so, show the method, including the directions and distances to other public land survey corners used as evidence or used for proportioning the corner location.

I, Donald Barnes, hereby certify that the corner location as identified by the corner code index was determined by me under my direction and control and that this U.S. Public Land Survey Monument Record is correct and complete to the best of my knowledge and belief.

seal

Number of included sheets 1

emboss
Donald Barnes
Oct 25 2000

CORNER CODE **X-21(1)**

A-E 7.08 REQUIREMENT


MILTON/
SHOPIERE
RD

REC 50.23
REC 50.00
REC 50.19

S89-58-01E

S34-35-25E 43.98
REC 43.88
REC 43.96

N34-52-54E 44.10
REC 44.15
REC 44.66

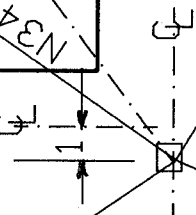

S5-46-39E 75.73
REC 75.65

S10-27-07E 59.09
REC 59.09

S58-36-39E 42.10
REC 42.09

N23-54-02E 42.81
REC 42.87
REC 42.81


N72-05-55E 55.99
REC 56.02

CTH MM

E 1/4 CDR
SEC 35
T3N R13E
HARMONY TWP

XXXXXXXXXXXXXXXXXXXX

MICRD TOWER
NS2-53-40E

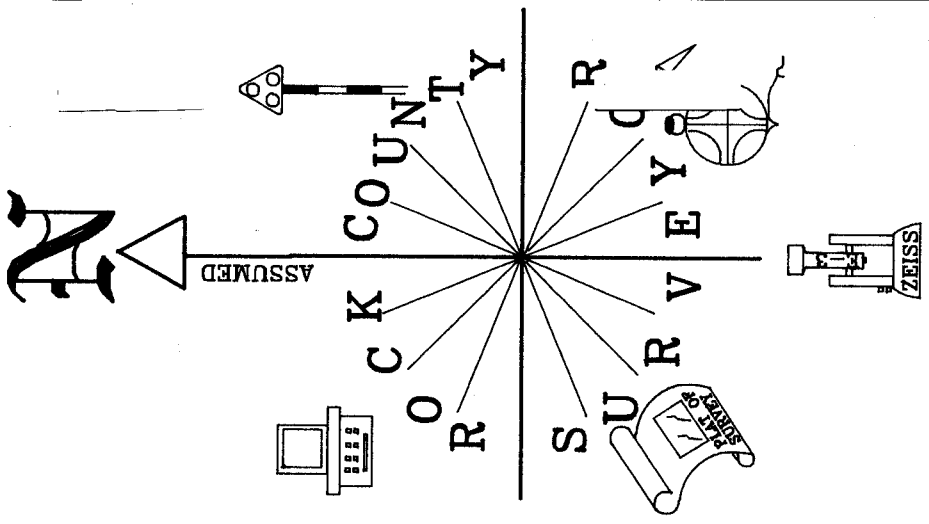

- FD 1" PIPE
 - FD POLY MON. 0.1' DEEP
- FB #2 PG 68

Paul James
EMBOSSSED
SEAL OCT 25, 2000

X21<1>