
PUBLIC LAND SURVEY MONUMENT RECORD

For Public Land Survey Corners in: $T. \frac{2}{N}$, $R. \frac{6}{E}$

WI ADMINISTRATIVE CODE A-E 7.08 REQUIREMENT

CORNER CODE INDEX

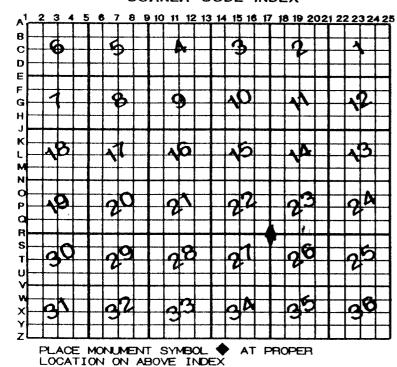

MAGK	10614	TWP
ROCK	COUNTY	WI

IF AVAILABLE
ROCK COUNTY COORDINATES PERFERRED

North	Elev	
East	***************************************	
Hor. Datum _	Vert, Datum	
LATITUDE	ELLIPS. H	
LONGITUTE		
GPS (X)	TRAVERSE (X)	
BASED ON THE	FOLLOWING CONTROL:	

•	CORNE	R MO	NUME	ENT
-				

O WITNESS MONUMENT

BEARINGS ARE BASED ON:

(a)

FIELD BOOKPAGE #	SHEET OF
SHOW A PLAN VIEW DRAWING DEPICTING THE CORNER MONUMENT	AND SURROUNDING
PHYSICAL FEATURES, INCLUDING THE EXCAVATION AREA AND DEPT	H.
PLANNING & ZONING COMMITTEE ADOPTED THE ABOVE FORM ON 12/2/1982	

MA589

- (B) Describe any record evidence, monument evidence, occupational evidence, testimonial evidence or any other material evidence you considered, and whether the monument was found or placed.
- 1868 LOCKE VOL 1 PG 326 COR LOST SET IT IN FROM CORNERS 1 MILE N, 1 MILE W, 1 MILE E, & ½ MILE SOUTH. SET BURR OAK STAKE WITH RED HH ON N & S & GRAY HH ON EAST, & L.S. ON WEST. 5320.92 TO SW COR SEC 22, 2657.60 TO E $\frac{1}{4}$ COR SEC 27, S 1/4 COR SEC 23, 2657.38 TO E 1/4 COR SEC 27, & 5317.76 TO NE COR **SEC 22.**
- LEE VOL 1 PG 353 FD COR SET BY LOCKE VAR 7-00 2662.44 TO N 1/4 COR & VAR 9-1869 00 2673.66 TO COR SET BY LOCKE @ E 1/4 COR OF SEC 27.
- 1870 LEE VOL 1 PG 356 FD STAKE SET BY LOCKE. VAR 7-30 2657.66 TO E 1/4 COR SEC
- 1929 BATTERMAN VOL 3 PG 164 & 165 GRADED OUT.
- 1974 LEE VOL 5 PG 17 SET ON LINE WITH N 1/4 & NW CORS SEC 27 DISTANCE **DOUBLED. REF. 9-23-74**
- 1974 LEE CSM 2671.92 TO E 1/4 COR SEC 27.
- 1978 BARNES VOL 5 PG 393 FD PK & SE & SW REFERENCE PIPES. 2661.30 TO E 1/4 COR SEC 22 & 5322.60 TO NE COR SEC 22.
- 1985 WIDOT R-17(3) ALUM MON? REFENCES SAME.
- 1986 BARNES VOL 6 PG 361 SHOWS OLD RECORD DISTANCES & FOLLOWING: N89-58-16E 2655.70 TO N ¼ COR SEC 26 {ON LINE WITH N ¼ & NW CORNERS SEC 26 AT **DOUBLED DISTANCE**
- 1988 BARNES VOL 6 PG 390 & 391 N0-47-45W 2661.14 TO E 1/4 COR SEC 22, N89-59-01E 2655.72 TO S ¼ COR SEC 23, S2-03-27E 2671.92 TO E ¼ COR SEC 22, S89-51-49W 2668.38 TO S ¼ COR SEC 22.
- 1986 BARNES R-17(1) FOUND WI STATE DOT REFERENCE MONUMENTS. FOUND PK IS NEW PAVEMENT. USED TIES TO ESTABLISH CORNER. PK IS 0.04' NORTH OF CORNER.
- 1987 BARNES R-17(2) USED DOT REFERENCE PIPES & 2 OF THE OLD REFERENCE PIPES. REFERENCED CORNER.
- 1996 BARNES VOL 6 PG 445 N0-09-38W 2661.18 TO E 1/4 COR SEC 22, N89-30-00W 2668.38 TO S 1/4 COR SEC 22, N0-09-45W 2660.93 FROM E 1/4 TO NE CORNERS SEC 22, & N89-30-05W 2667.83 FROM S 1/4 COR TO SW CORNERS OF SEC 22.

DID NOT FIND PK. FD PK @ TRAV COR TO THE EAST. FD REFERENCE PIPES OF RECORD. PVMT SURFACE WILL BE GROUND OUT.

- C) Was the corner restored through acceptance of (1) an obliterated evidence location, or, (2) a found perpetuated location?
- D) Describe any material discrepancy between the location of the corner as restored or reestablished and the location of that corner as previously restored or reestablished by distance and direction. Show the discrepancy on the plan view drawing under (a), above. Show the distances between the corner as previously restored or reestablished and (1) the corner as restored or reestablished, and (2) to at least 4 of the witness monuments shown on the drawing in (a), above.
- (E) Was the corner reestablished through lost corner proportionate methods? If so, show the method, including the directions and distances to other public land survey corners used as evidence or used for proportioning the
- I, Donald Barnes, hereby certify that the corner location as identified by the corner code index was determined by me under my direction and control and that this U.S. Public Land Survey Monument Record is correct and complete to the best of my knowledge and belief.

Seal

Number of included sheets 1

Considerances
Emboss
May 15, 2000

CORNER CODE R-17(3)