

U.S. PUBLIC LAND SURVEY MONUMENT RECORD

For Public Land Survey Corners In:

WI ADMINISTRATIVE CODE A-E 7.08 REQUIREMENT

T. 3 N. R. 10 E. 4th P.M.

REV 10/23/2004

USMONREC.DWG

CORNER CODE INDEX

MAGNOLIA TWP

ROCK COUNTY WI

IF AVAILABLE

ROCK COUNTY COORDINATES PREFERRED

| | | | | | | | | | | | | | | | | | | | | | | | | | | | |
|---|---|---|---|---|---|---|---|---|---|----|----|----|----|----|----|----|----|----|----|----|----|----|----|----|----|--|---|
| | 1 | 2 | 3 | 4 | 5 | 6 | 7 | 8 | 9 | 10 | 11 | 12 | 13 | 14 | 15 | 16 | 17 | 18 | 19 | 20 | 21 | 22 | 23 | 24 | 25 | | |
| A | | | | | | | | | | | | | | | | | | | | | | | | | | | A |
| B | | | | | | | | | | | | | | | | | | | | | | | | | | | B |
| C | | | | | | | | | | | | | | | | | | | | | | | | | | | C |
| D | | | | | | | | | | | | | | | | | | | | | | | | | | | D |
| E | | | | | | | | | | | | | | | | | | | | | | | | | | | E |
| F | | | | | | | | | | | | | | | | | | | | | | | | | | | F |
| G | | | | | | | | | | | | | | | | | | | | | | | | | | | G |
| H | | | | | | | | | | | | | | | | | | | | | | | | | | | H |
| J | | | | | | | | | | | | | | | | | | | | | | | | | | | J |
| K | | | | | | | | | | | | | | | | | | | | | | | | | | | K |
| L | | | | | | | | | | | | | | | | | | | | | | | | | | | L |
| M | | | | | | | | | | | | | | | | | | | | | | | | | | | M |
| N | | | | | | | | | | | | | | | | | | | | | | | | | | | N |
| O | | | | | | | | | | | | | | | | | | | | | | | | | | | O |
| P | | | | | | | | | | | | | | | | | | | | | | | | | | | P |
| Q | | | | | | | | | | | | | | | | | | | | | | | | | | | Q |
| R | | | | | | | | | | | | | | | | | | | | | | | | | | | R |
| S | | | | | | | | | | | | | | | | | | | | | | | | | | | S |
| T | | | | | | | | | | | | | | | | | | | | | | | | | | | T |
| U | | | | | | | | | | | | | | | | | | | | | | | | | | | U |
| V | | | | | | | | | | | | | | | | | | | | | | | | | | | V |
| W | | | | | | | | | | | | | | | | | | | | | | | | | | | W |
| X | | | | | | | | | | | | | | | | | | | | | | | | | | | X |
| Y | | | | | | | | | | | | | | | | | | | | | | | | | | | Y |
| Z | | | | | | | | | | | | | | | | | | | | | | | | | | | Z |

North _____ Elev. _____

East _____

Hor. Datum _____ Vert. Datum _____

LATITUDE _____ ELLIPS. HT. _____

LONGITUDE _____

NAD83(91) _____ NETWORK ADJ. YR 2010

GPS (X) _____ TRAVERSE (X) X

BASED ON THE FOLLOWING CONTROL:

1 2 3 4 5 6 7 8 9 10 11 12 13 14 15 16 17 18 19 20 21 22 23 24 25
PLACE MONUMENT SYMBOL **◆** AT PROPER LOCATION ON ABOVE INDEX

◆ CORNER MONUMENT

○ WITNESS MONUMENT

(a)

BEARINGS ARE BASED ON: ROCK COUNTY PROJECTION

FIELD BOOK _____ PAGE # _____
OR OBSERVATION SHEET _____

SHEET 1 OF 2

SHOW A PLAN VIEW DRAWING DEPICTING THE CORNER MONUMENT AND SURROUNDING PHYSICAL FEATURES, INCLUDING THE EXCAVATION AREA AND DEPTH.

PLANNING & ZONING COMMITTEE ADOPTED THIS FORM ON 12/2/1982

CORNER CODE J-1(1)

MA541 SWCORSEC7

(B) Describe any record evidence, monument evidence, occupational evidence, testimonial evidence or any other material evidence you considered, and whether the monument was found or placed.

1833 MULLETTE (SEP 11TH) NORTH ON EAST SIDE SEC 24

1233.54 BUR OAK 16

2640.0 SET 1/4 SEC POST BUR OAK 10 N31 1/2W 21.78',
BUR OAK 16 S20W 26.4' BUR OAK 16

5280.00 SET POST CORNER SECTIONS 13 & 24 W. OAK 12
S73W 201.96', BLACK OAK 4 N40W 67.32'

NORTH EAST SIDE SEC 13

2640.00 SET 1/4 SECTION POST BUR OAK 16 S30W 30.36',
BUR OAK 15 N49W 63.36'

5280.00 SET POST CORNER SECTIONS 12 & 13 BUR OAK 14
S13W 108.9', BUR OAK 18 N20W 36.96'

1833 HARRISON (DEC 7TH) START DEC 1ST FINISHED DEC 7TH

WEST BET SECS 6 & 7

1947.0 SPRING BROOK 5.28' CRS SOUTH

2046 CREEK 33' CRS N.W.

2640.0 QUARTER SEC COR {BUR O 12 SBW 198'? NO OTHER
NEAR BURR O 12} MARKED

3432 ENTER SCATTERING TIMBER IN CREEK BOTTOM

5335.44 INT. W BDY. SET COR TO 6 & 7 {BURR O 18 N46E
205.26'

LAND LEVEL & WET 3RD RATE TIMBER BURR O.

WEST BET. SECS 7 & 18

1184.7 BURR O 12 IN DIAM.

2640.00 QUARTER SEC COR {RED O 10 N35W 22.44', W.O. 10
S67W 17.82'} RED O 16, WO 10} MARKED

5344.68 INT W. BOUNDARY {BURR OAK 18 N51E178.2' & BURR
OAK 12 S75E 221.1'.

1833 HARRISON (DEC 8TH) TWP START DEC 8TH FINISHED FEB 8TH

EAST ON RAND BET 12 & 13

1881 LEAVE MARSH

2640 TEMPY 1/4 SEC. COR

2937.0 SPRING BROOK 5.28' CRS N 2 & 3 CH S OF LIME ??
?? SPRING

5227.0 INT. E BDY 198' N OF P

LAND GENERALLY LEVEL 3 RD RATE AND WET WITH
TIMBER OF RED & BURR OAK.

EAST ON RAN BET 13 & 24 T3N R9E

2640.0 TEMPY 1/4 SEC COR.

5226.54 INT. E BDY 124.08' N OF POST LAND LEVEL 2ND RATE
TIMBER WHITE OAK & BURR & UNDERGROWTH GRASS
& WEEDS

1855 CHURCH VOL 1 PG 53 2680.92 TO S 1/4 COR SEC 7 & 2610.96 TO
W 1/4 COR SEC 7 & 5221.92 TO NW COR SEC 7.

1873 RUGER VOL 2 PG 109 CORNER IS 9.24' NORTH OF E/W BOARD
FENCE. FOUND REMAINS OF OLD STAKE. ALSO NE BT THE STUMP
OF THE SE BT HAD BEEN DUG UP. DROVE NEW STAKE DEEP & PUT
ON TOP OF IT HH STONE 18X13X11 SURROUNDED 5 SMALL HH
STONES. VAR 6-18 2677.02' TO N 1/4 COR SEC 18, VAR 6-50
2666.4 TO W 1/4 COR SEC 18 & VAR 6-50 5332.80' TO SW COR SEC
18 (FD IRREGULAR HH STONE ON COR. SAID STONE MEASURED
21X21X13. ALSO FD S.E. BT & STUMP OF NE BT. VAR 6-50
1287.66'

Embossed
Seal

Donald Haines

2-11-2011

SHEET 1 OF 2

CORNER CODE J-1(1)

MA541

SWCORSEC7

TO NE COR SEC 24 [FD REMAINS OF OLD STAKE. ALSO NW BT & REMAINS OF STUMP OF SW BT. DROVE NEW STAKE DEEP & PUT ON TOP OF IT SANDSTONE 17X12X7], NE COR SEC 24 IS 45.54' NORTH OF W 1/16TH COR OF NW 1/4 SEC 18 [DROVE STAKE DEEP & PUT ON TOP OF IT SANDSTONE 12X9X5].

1937 SUNNY VOL 3 PG 353 AT W 1/4 COR SEC 7 FOUND HH MON. SET BY RUGER. SET 1 1/2X10" PIPE WITH CAP ON TOP FLUSH WITH BLACKTOP PAVEMENT. SET 1 1/2 X30" REFERENCE PIPES 33.00 TO THE EAST & WEST. MAP INDICATES CORNER IS ON LINE WITH E/W FENCE. AT SW COR SEC 7 DUG 5X6 4 1/2' DEEP HOLE & FOUND NO MON. AT E 1/4 COR SEC 24 T3N R9E DUG 3X4X4 DEEP HOLE & FD NO MON. 2621.4 TO CENTER OF E/W PVMT AT W 1/4 COR SEC 7 WITH STATEMENT "THIS CORNER IS NOT IN BLACKTOP"

1995 BARNES VOL 6 PG 443 SW COR SEC 7 N89-58-06E 1374.27 TO S 1/16TH COR OF SW 1/4 SEC 7. 1/16TH COR TO S 1/4 COR SEC 7 IS N89-59-46E 1311.62, SW COR SEC 7 TO S 1/4 COR SEC 7 IS N89-58-55E 2685.88. SW COR SEC 7 TO W 1/16TH COR OF NW 1/4 SEC 18 S00-30-41E 1334.66, W1/16TH COR TO W 1/4 COR SEC 18 IS S00-30-41E 1334.66. W 1/16TH COR NW 1/4 SEC 18 TO SE COR SEC 13 N0-30-41W 45.54, SE COR SEC 13 TO E 1/4 COR SEC 13 N0-17-47W 2630.27. SW COR SEC 7 TO W 1/4 COR SEC 7 IS N0-19-11W 2624.40

1995 BARNES J-1 DUG AND FOUND OLD ASPHALT PAVEMENT 5.5' BELOW PRESENT PAVEMENT. 11" BELOW OLD PAVEMENT FOUND HH 18X11X12 WITH HH ON SOUTH, EAST, WEST, & NORTH. 3.7' WEST OF CENTER OF PAVEMENT. FOUND OLD STAKE BELOW HH & 2' BELOW OLD ROAD BED. REPLACED STAKE WITH 3/4X24 REROD AT ORIGINAL DEPTH. WILL INSTALL MONUMENT AFTER HOLE IS REPAIRED. REFERENCED IT. SHOWS S 1/16TH COR OF SW 1/4 SEC 7 AS 0.32' SOUTH OF A LINE BETWEEN THE S 1/4 COR & SW COR OF SEC 7. SHOWS THE ALUM MON NEAR THE SE COR SEC 13 AS 3.06' WEST OF A LINE BETWEEN THE NW COR SEC 18 & THE SW COR SEC 18. SHOWS MY SE COR SEC 13 COR AS 0.12' WEST OF A LINE BETWEEN THE NW COR SEC 18 & THE SW COR SEC 18.


C) Was the corner restored through acceptance of (1) an obliterated evidence location, or, (2) a found perpetuated location?

ACCEPTED FOUND HH & STAKE.

D) Describe any material discrepancy between the location of the corner as restored or reestablished and the location of that corner as previously restored or reestablished by distance and direction. Show the discrepancy on the plan view drawing under (a), above. Show the distances between the corner as previously restored or reestablished and (1) the corner as restored or reestablished, and (2) to at least 4 of the witness monuments shown on the drawing in (a), above.

I, Donald Barnes, hereby certify that the corner location as identified by the corner code index was determined by me under my direction and control and that this U.S. Public Land Survey Monument Record is correct and complete to the best of my knowledge and belief.

Embossed
Seal

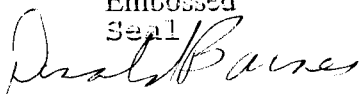

SHEET 2 OF 2

CORNER CODE **J-1 (1)**

2-11-2011

A-E 7.08 REQUIREMENT