

U.S. PUBLIC LAND SURVEY MONUMENT RECORD

For Public Land Survey Corners in:

WI ADMINISTRATIVE CODE A-E 7.08 REQUIREMENT

T. 1 N., R. 12 E

BELOIT TWP TWP

CORNER CODE INDEX

ROCK COUNTY WI

A	1	2	3	4	5	6	7	8	9	10	11	12	13	14	15	16	17	18	19	20	21	22	23	24	25
B																									
C	6																								
D																									
E																									
F																									
G	7																								
H																									
J																									
K																									
L	18																								
M																									
N																									
O																									
P	19																								
Q																									
R																									
S																									
T	30																								
U																									
V																									
W																									
X	31																								
Y																									
Z																									

IF AVAILABLE
ROCK COUNTY COORDINATES PREFERRED

North 203,743.98 Elev. _____

East 485,595.99

Hor. Datum County Vert. Datum _____

LATITUDE _____ ELLIPS. HT. _____

LONGITUDE _____

GPS (X) _____ TRAVERSE (X) _____

BASED ON THE FOLLOWING CONTROL:

PLACE MONUMENT SYMBOL AT PROPER LOCATION ON ABOVE INDEX

CORNER MONUMENT

WITNESS MONUMENT

(a)

BEARINGS ARE BASED ON:

OBSERVATION

FIELD BOOK SHEET PAGE # STA 377

SHEET 1 OF 2

SHOW A PLAN VIEW DRAWING DEPICTING THE CORNER MONUMENT AND SURROUNDING PHYSICAL FEATURES, INCLUDING THE EXCAVATION AREA AND DEPTH.

PLANNING & ZONING COMMITTEE ADOPTED THE ABOVE FORM ON 12/2/1982

CORNER CODE X-17

BE618

(B) Describe any record evidence, monument evidence, occupational evidence, testimonial evidence or any other material evidence you considered, and whether the monument was found or placed.

1834 HARRISON NORTH BETWEEN SECTIONS 34 & 35 VAR 7-00 (MARCH 16TH)

2640 SET POST FOR COR TO QUARTER SECTION IN PRAIRIE IN A LEVEL PLAIN GENTLY DESCENDING EASTWARDLY TOWARD ROCK RIVER. RAISED A MOUND OF SOD.

5280 SET A POST FOR CORNER TO SECTIONS 26, 27, 34, & 35 ON SAME PLAIN MARKED POST & RAISED MOUND.

1850 FROWBRIDE - WALKER'S ADD BK 2 PG 21 & 22. CALLS FOR CORNER BUT STATES NOTHING ABOUT IT. S88-30E ALONG E/W CENTER SEC 35 & N1E ALONG WEST LINE OF NW 1/4 SEC 35.

1857 CHURCH BK 3 PG 25 ANGLE OF 90-24 FROM SE COR SEC 34 TO CENTER SEC 34.

1867 COLLINS - PIERCES' ADD BK 3 PG 51. CALLS FOR CORNER BUT STATES NOTHING ABOUT IT. BEARING OF SEC. LINE TO THE SOUTH IS S0-07E AND BEARING OF CENTER OF ST TO SE IS S63-28E. BOTH LINES ARE 33' FROM THE PROPERTY LINES.

1889 HOLMES - MCGAVOCKS' ADD. BK 4 PG 45 CALLS FOR STONE, BEARING N3-14W, N87-08E ALONG SECTION LINE & 1/4 LINE, N87-08E 315.40' TO PIPE @ 11TH ST., 642.4' TO PIPE @ 10 ST, N3-14W 664.3 TO ROD @ ST INTERSECTION, & ANGLE 90-22 FROM NW TO CENTER SEC 35

1890 WILSON - GESLEY'S ADD BK 4 PG 56. CALLS FOR STONE & 1329.5 TO 1/16TH CORNER TO THE WEST.

1893 WILSON BK 5 PG 11 ANGLE OF 89-30 FROM CENTER SEC 34 TO NE COR SEC 34, 1329.58 TO S 1/16TH COR OF NE 1/4 SEC 34, & 90-35-00 @ NE COR SEC 34 FROM E 1/4 COR SEC 34 TO N 1/4 COR SEC 34.

1912 GOLDWELL - REITLERS' ADD B7 PG 53 CALLS FOR CORNER BUT STATES NOTHING ABOUT IT. S89-32E 315.2 TO PIN AT CENTER OF INTERSECTION TO THE EAST, AND BEARING OF CENTER OF STREET TO SE AS S63-28E.

19?? SHIMEALL MAP #6088 ANGLE OF 89-30-24 FROM CENTER SEC 35 TO SW COR SEC 35 & ANGLE OF 90-07-40 @ SW COR SEC 35 FROM W 1/4 COR TO M.P. ON SOUTH LINE SEC 35, 2669.91 TO CENTER OF SEC 35, 2637.94 TO SE COR SEC 34.

CORNER IS 2' SOUTH OF SOUTH EDGE OF MAN HOLE COVER, 2.5 SOUTH OF E/W CENTER LINE OF PAVEMENT, & CENTER LINE OF N/S PAVEMENT. DID NOT EXCAVATE FOR CORNER BECAUSE OF CLOSE PROXIMITY OF MAN HOLE COVER. ESTABLISHED CORNER IN HARMONY WITH FOUND PROPERTY CORNERS AS SHOWN IN MONUMENT RECORD. DID NOT PLACE MONUMENT.

C) Was the corner restored through acceptance of (1) an obliterated evidence location, or, (2) a found perpetuated location? CORNER RESTORED THROUGH ACCEPTANCE OF OBLITERATED EVIDENCE LOCATION AS DESCRIBED ABOVE.

(E) Was the corner reestablished through lost corner proportionate methods? If so, show the method, including the directions and distances to other public land survey corners used as evidence or used for proportioning the corner location. NO

I, Donald Barnes, hereby certify that the corner points as identified by the corner code index were, in a field survey on, SEP 12, 1997, established, re-established, monumented, re-monumented, recovered or restored as expressed below and in conformance with the regulations and rules as required in the current manual of survey instructions of the United States Department of Interior, Bureau of Land Management.

Donald Barnes
Seal
OCT 20, 1998

EMBOSS LAND SURVEYOR SEAL


COUNTY SURVEYOR FILING DATA

Number of included sheets _____
CORNER CODE

A-E 7.08 REQUIREMENT

X-17

SE COR
SEC 27

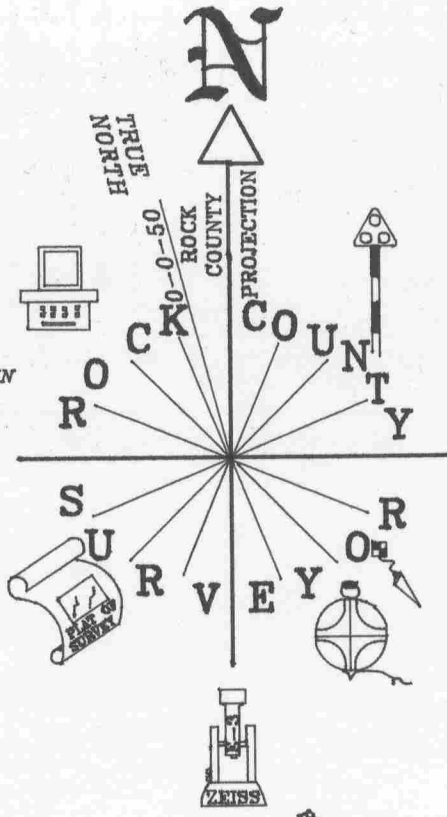

66.00
S89-41-48E
REC 33 REC 33
FD 1 1/4" PIPE ○ FD 3/4" PIN

NO-11-11V 399.31
REC 398.88

NO-30-46W 234.14
REC 248.22
AT HELOIT COLLEGE
REC N3-14W MAG. VAR 5-17E
LINE BETWEEN SE COR
SEC 27 TO POINT "A"

FD 1" PIPE ○

NO-16-27E 185.18
REC 174.64

THE BELOIT LAND AND
INVESTMENT CO.'
2ND ADD FD 1" METAL BAR ○
BK 5 PG 11

McGAVOCK'S ADD.
BK 5 PG 11

REC 89-30
89-32-17 REC 90-24
REC 2859.16
2858.60 REC 90-24
REC 90-24-29 REC 63-21
28-26
26-04
25-04-20

ROAD

ROAD

REC 33
FD PIPE
IN RD. MON.
33.00 BOX

REC 157.8
S89-42-59E 157.56

REC 52.6
S89-40-06E 52.37

REC 52.6
S89-55-30E 52.37

REC 33
32.72

REC 251.51
REC 252.4
S89-43-27E 252.10

REC 66
86.07

REC 33
REC 66
S89-34-36E
FD 1" PIPE

REC 33
REC 66
S89-34-36E
FD 1" PIPE

REC 33
REC 66
S89-34-36E
FD 1" PIPE

REC 33
REC 66
S89-34-36E
FD 1" PIPE

LINE BETWEEN SE COR SEC
27 & CENTER OF SEC 27

LAWRENCE ST
REC N77-08E MAG REC 314.81
COLLEGE S89-45-05E 314.84
TO POINT "F"

E 1/4 COR
SEC 34

BLODGETT & KING'S
ADD.
BK 3 PG 25

REITLER'S ADD.
BK 7 PG 53
ASSESSOR'S PLAT
BK 10 PG 35

REC 198

REC 198

Donald Barnes
Oct 20, 1998

PIERCE'S ADD.
BK 3 PG 51

X-17

