Paper weigh_____inimum) _____ Black no_____ required

# U.S. PUBLIC LAND SURVEY MONUMENT RECORD

For Public Land Survey Corners in:

T. 1 N., R. 10 E

WI ADMINISTRATIVE CODE A-E 7.08 REQUIREMENT

CORNER CODE INDEX

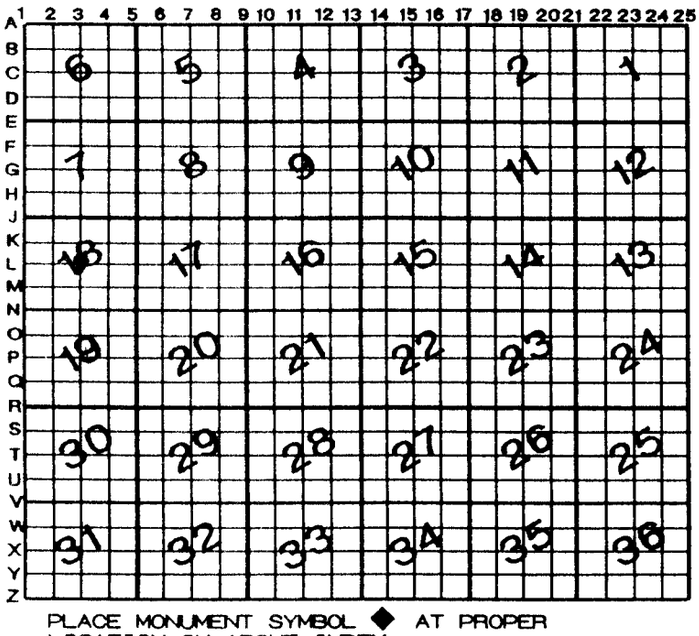


PLACE MONUMENT SYMBOL ◆ AT PROPER LOCATION ON ABOVE INDEX

AVON TWP

ROCK COUNTY WI

IF AVAILABLE
ROCK COUNTY COORDINATES PERFERRED

North 221,227.70 Elev. _____

East 403,345.19

Hor. Datum _____ Vert. Datum _____

LATITUDE _____ ELLIPS. HT.

LONGITUTE _____ _____

GPS (X) ___ TRAVERSE (X) ___

BASED ON THE FOLLOWING CONTROL:

◆ CORNER MONUMENT ○ WITNESS MONUMENT

(a)

BEARINGS ARE BASED ON:

BATTERMAN FOUND METAL GRATE

COORDINATE PROVIDED BY R.H BATTERMAN Company

Donald Barnes
APRIL 30, 2003

FIELD BOOK _____ PAGE # _____ SHEET 1 OF 1

SHOW A PLAN VIEW DRAWING DEPICTING THE CORNER MONUMENT AND SURROUNDING PHYSICAL FEATURES, INCLUDING THE EXCAVATION AREA AND DEPTH.

PLANNING & ZONING COMMITTEE ADOPTED THE ABOVE FORM ON 12/2/1982

CORNER CODE 1-3