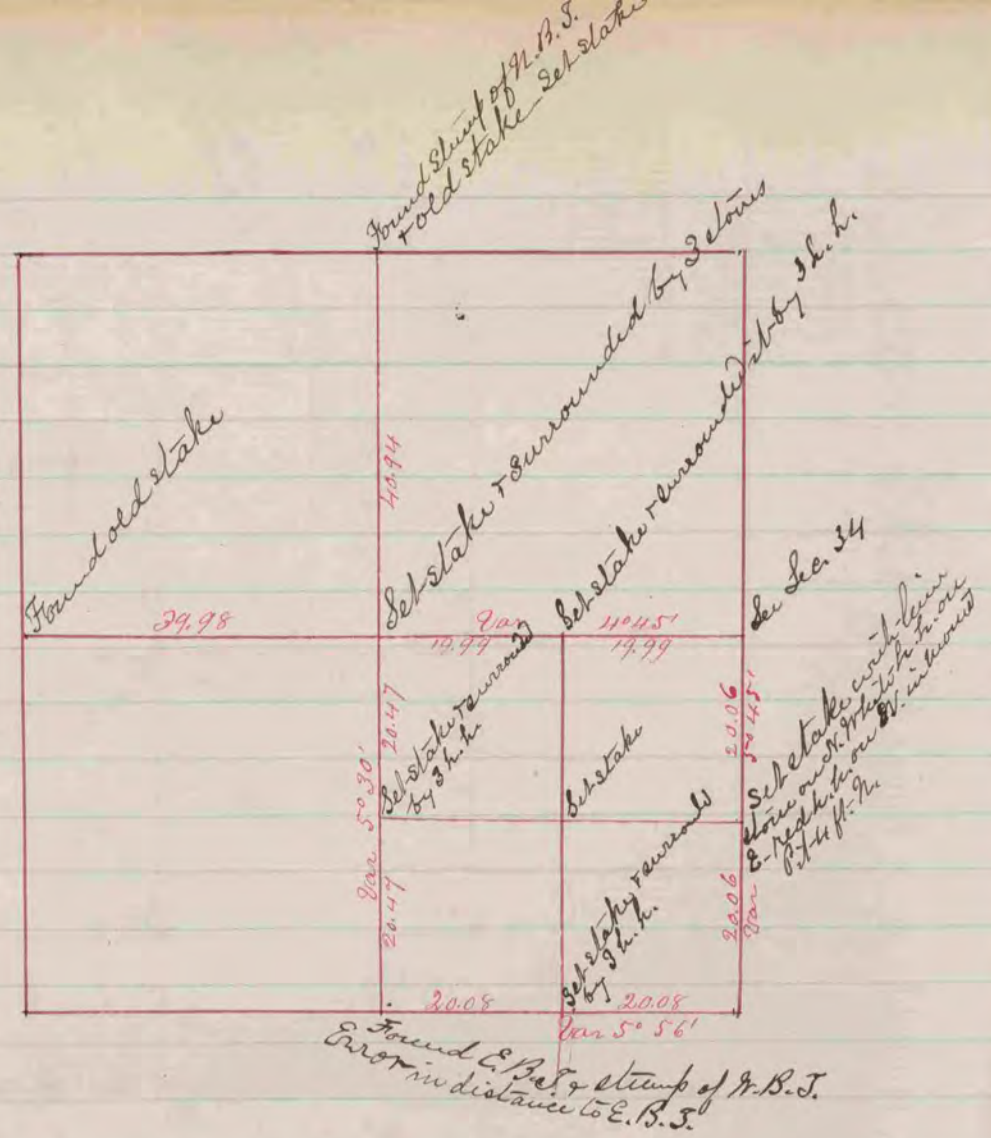

A Record + Plat of a survey made April 5&6 1865 on Sec. 33. Newark by S. D. Locke Co. Surveyor

The above is a correct Record + Plat of a survey made by me April 9- 1869 on Sec. 15- T. 3. R. 12 Janesville

COUNTY SURVEYOR
RECORD 1859-1906