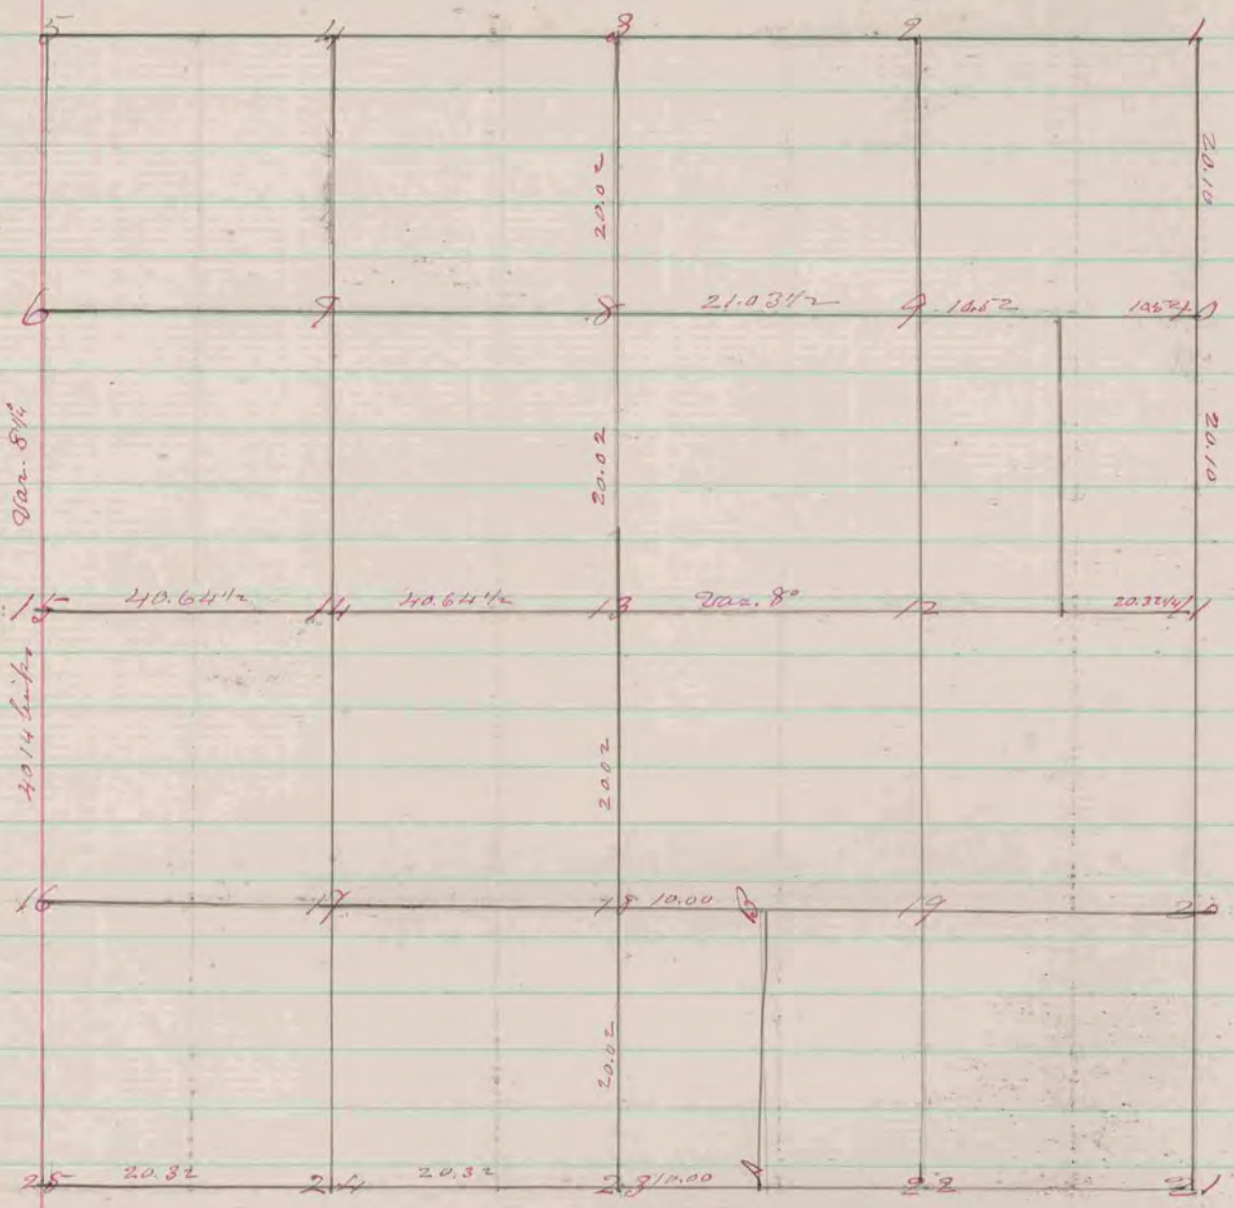

Fig 14 Mit- W.O. 36 S 2½ W 27
30 N 51 E 125
" 24 Br O 20 S 3½ W 63
" 24 S 57 W 115 Fig. 12 Br O 12 S 27½ W 82½
8 " 20 N 18 W 84½ " 20 S 32 E 106
" 24 N 93 E 169
10 W O 30 N 25½ E 63
36 S 11 W 141½
9 Br O. 12 N 47 E 22½
24 S 36 51
13 Stake in Marsh
A Record of Plat of a survey made on Sec. 8
T 4 R. 10 E. Union March 4 & 5 1856
Joseph Church Co. Surveyor

COUNTY SURVEYOR
RECORD 1859-1906