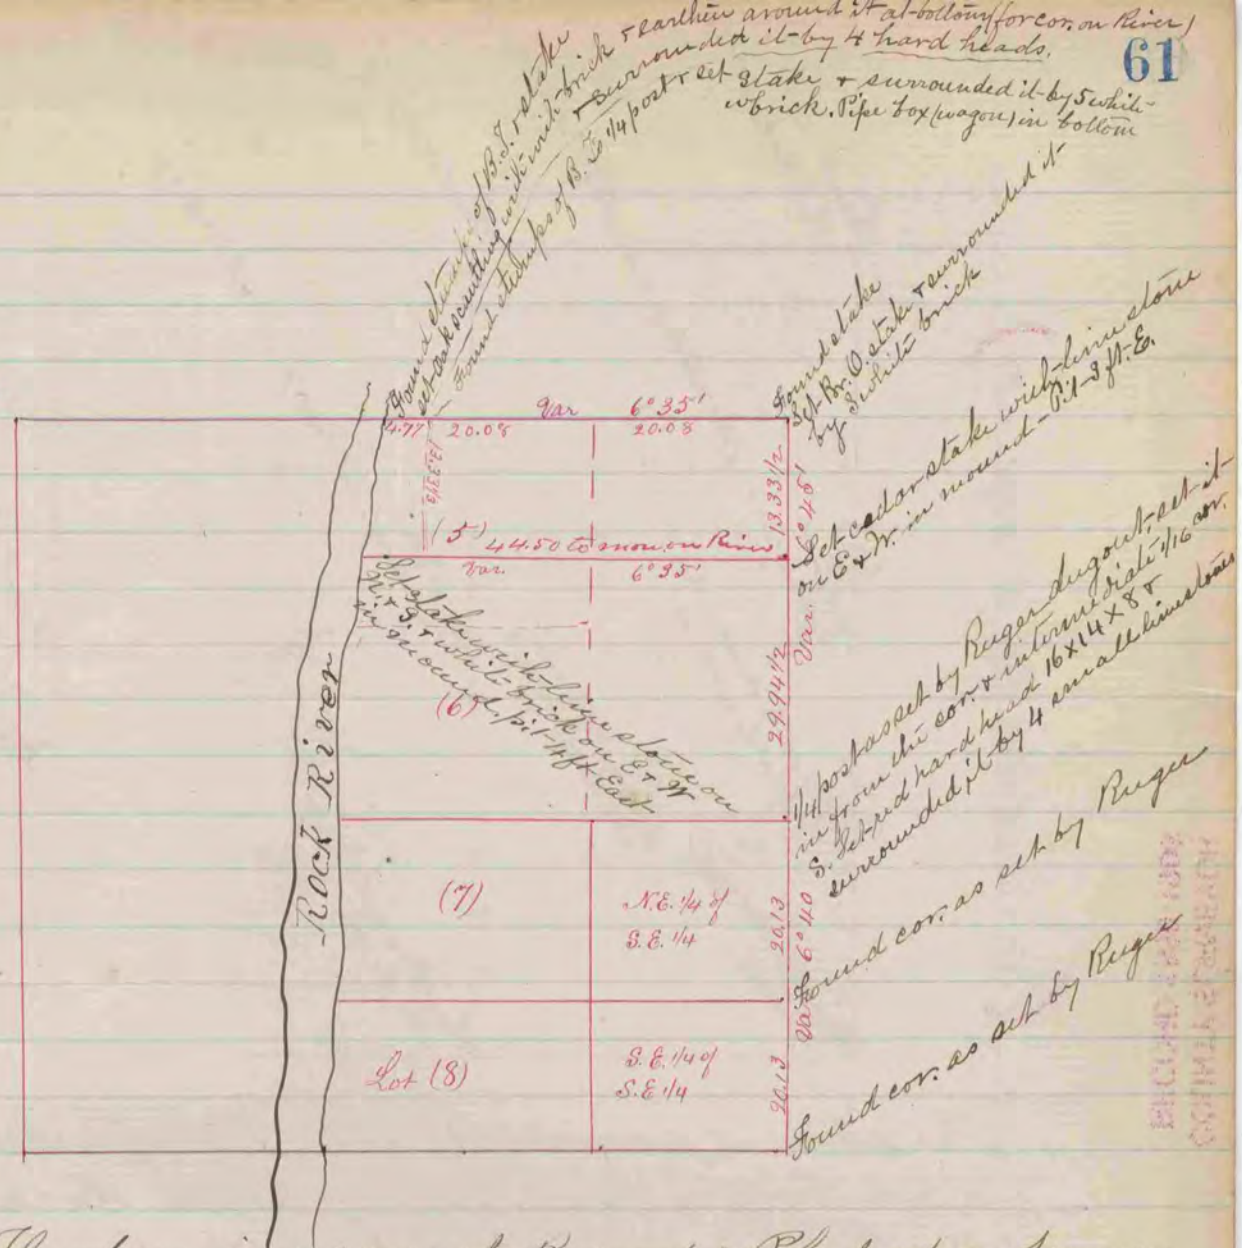

(Recorded in Vol I page 284)

The above is a correct Record & Plat of a Survey made by me April 26. 1867 on Sec. 15 Rock
S. D. Locke Co. Surveyor

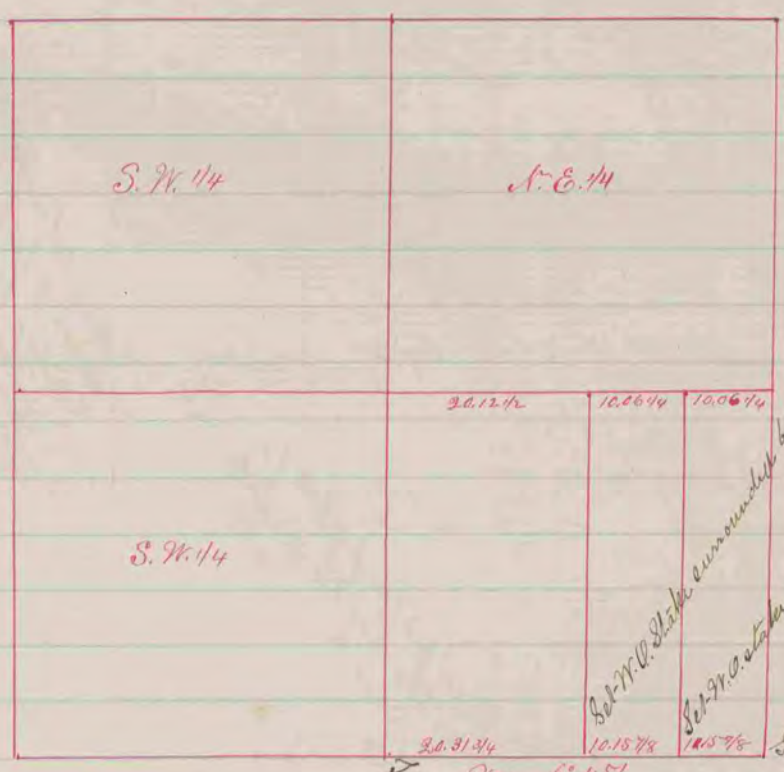

(Recorded in Vol I page 316)

The above is a correct Record & Plat
of a Survey made by me April 13. 1868 on Sec. 8. Rock
S. D. Locke Co. Surveyor

COUNTY SURVEYOR
RECORD 1859-1906