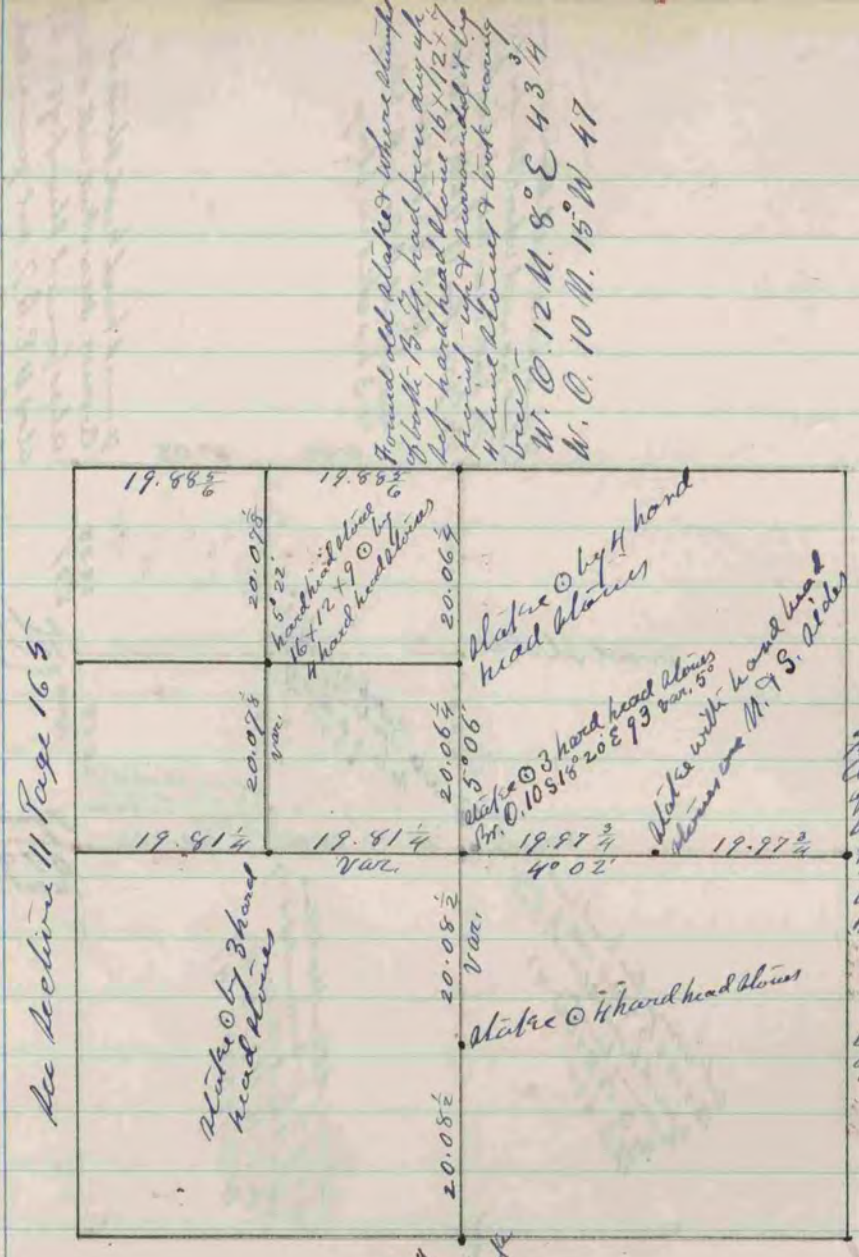

The above is a record and plat of a survey made by me on Section 12 - Tract June 13 & 14 1876

Edward Ruger
County Surveyor

COUNTY SURVEYOR
RECORD 2 1869-1900