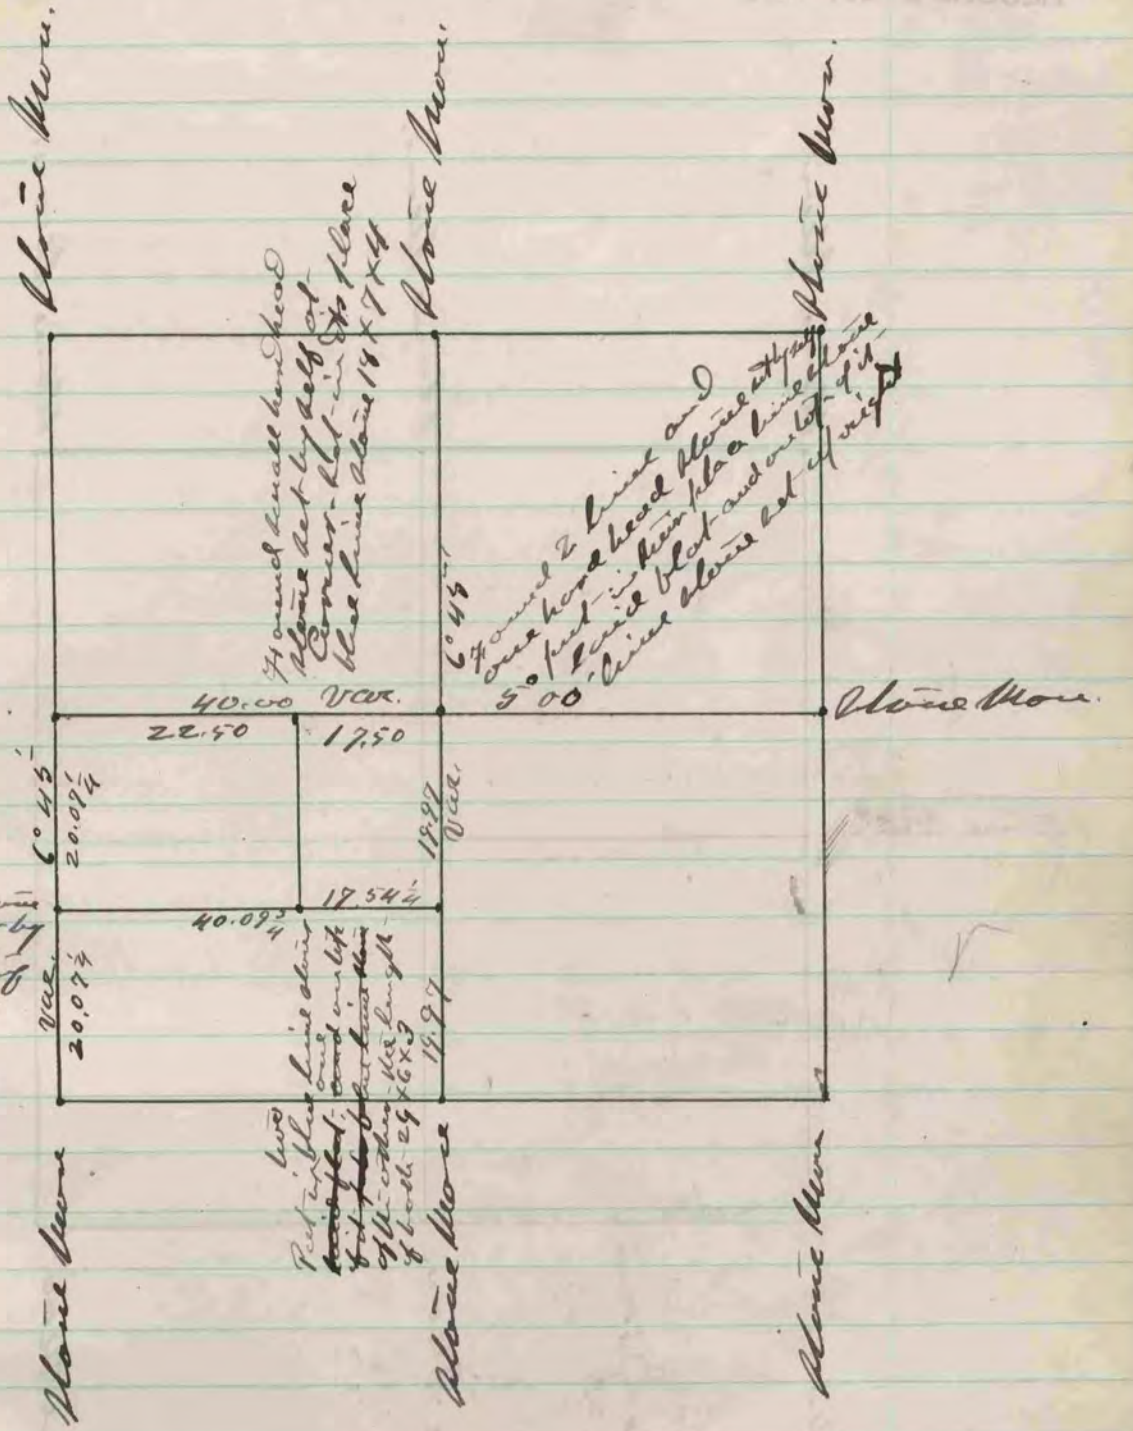
40.00 Var.
22.50
17.50
6° 45' E
20.09 1/4
19.97 Var.
17.54 1/4
40.09 3/4
20.07 1/2
19.97
6° 45' E
5° 00'
Var.
Var.
Var.