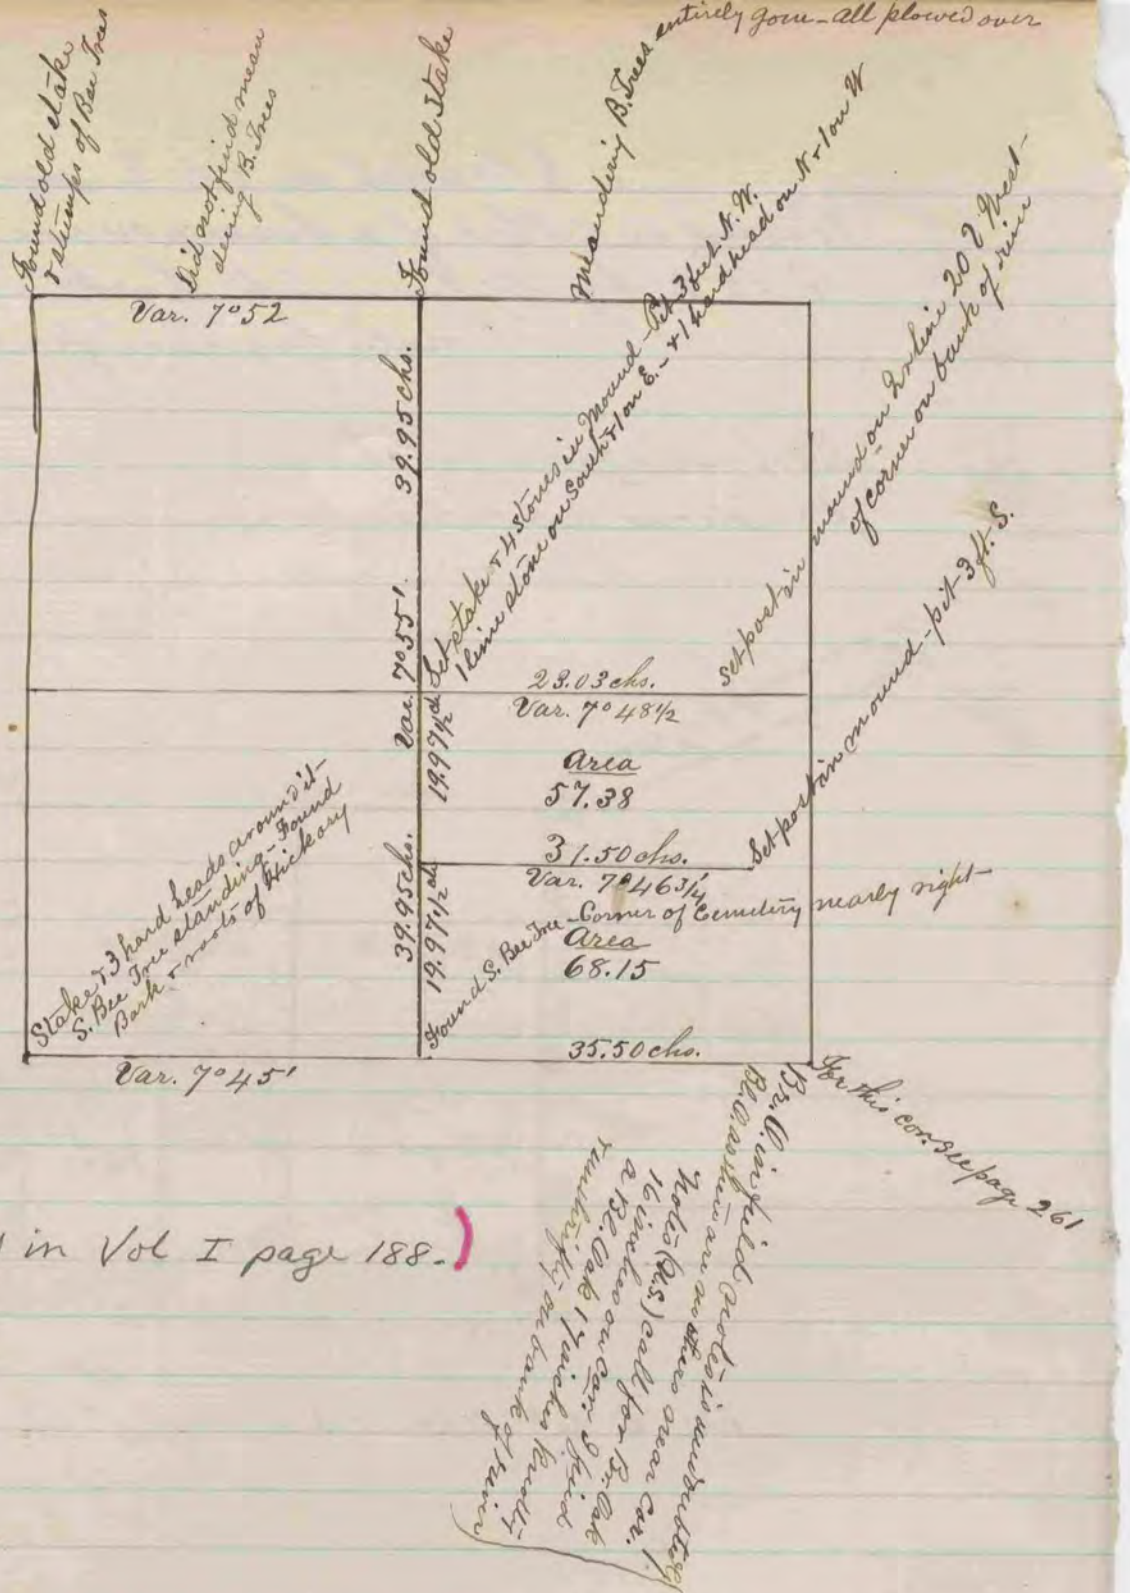

(Recorded in Vol I page 188.)

A Record & Plat of a Survey made on Sec. 23. T. 19 R. 12. E. Aug. 14-18 & 20 1863. by S. D. Locke County Surveyor for Rock Co. Wis.

Meander line of river Commences on South line of Section at Br. on Bl. Oak 17 inches on Corner on River, running thence North-19½ West 3 chs; thence N. 17½ W. 5 chs; thence N. 13½ W. 7 chs. thence N. 15½ W. 2 chs; thence N. 20½ W. 2 chs; thence N. 60¾ W. 1.74½ chs. thence N. 13 E. 2 chs. thence N. 12 W. 1 ch, thence N. 28¾ W. 4 chs, thence N. 32 W. 2.75 chs, thence N. 31. W. 3.27 chs. thence N. 39¼ W. 4 chs; thence N. 45 W. 2 chs; thence N. 42 W. 3.65 chs. to the Quarter Line, 20 Links East of Post in Mound

Bearings given according to Magnetic Meridian, as indicated by needle.

COUNTY SURVEYOR
RECORD 1859-1906