COUNTY SURVEYOR
RECORD 1859-1906

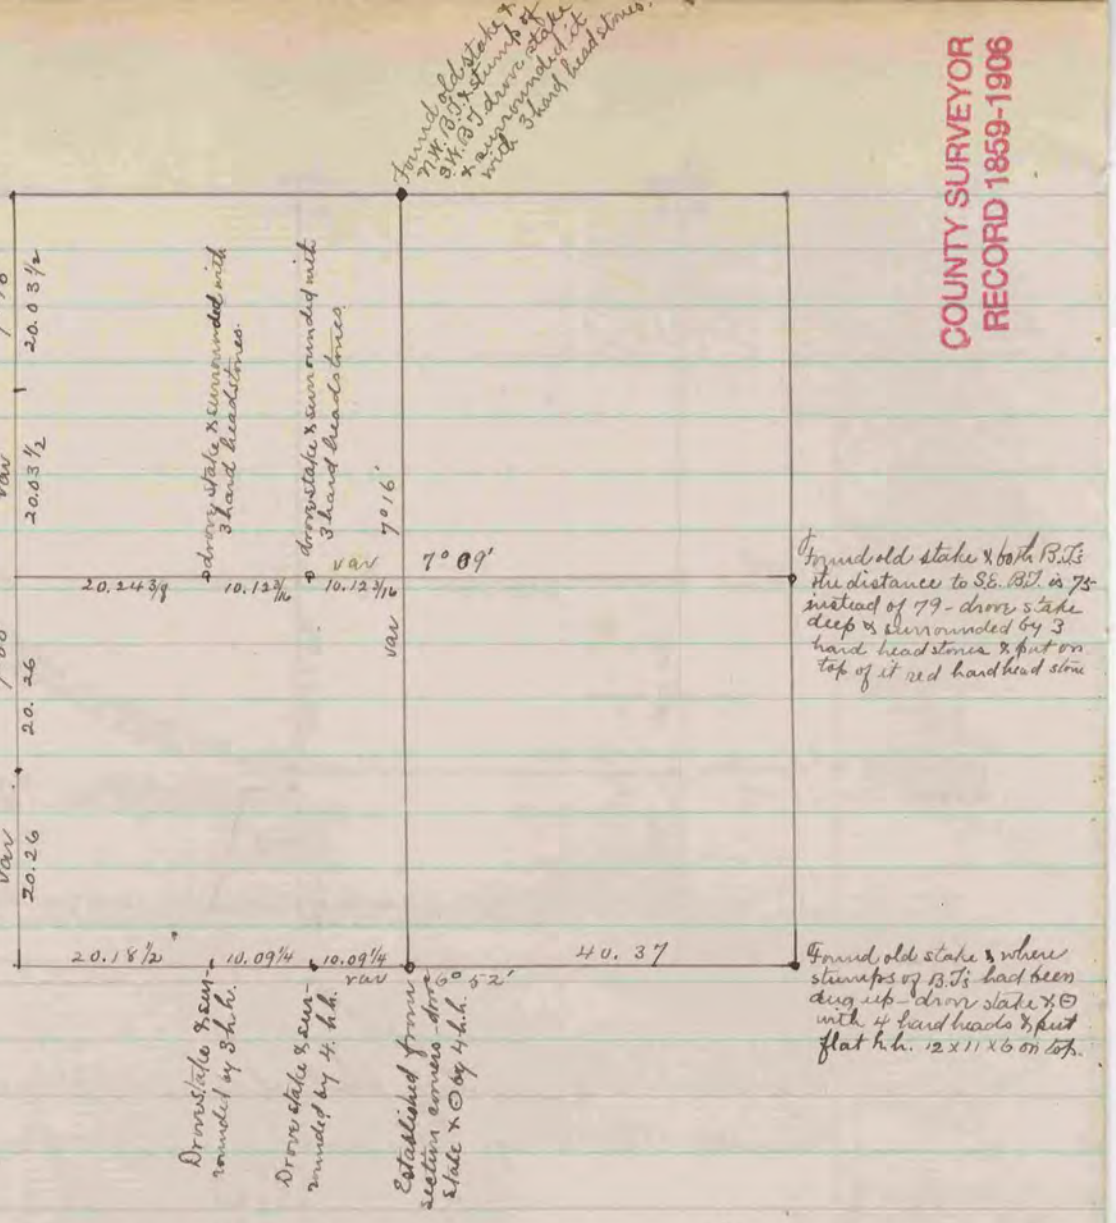

The above is a record & plat of a survey made on Sec. 28 Porter June 8 & 9, 1871 by Edward Ruger, County Surveyor.

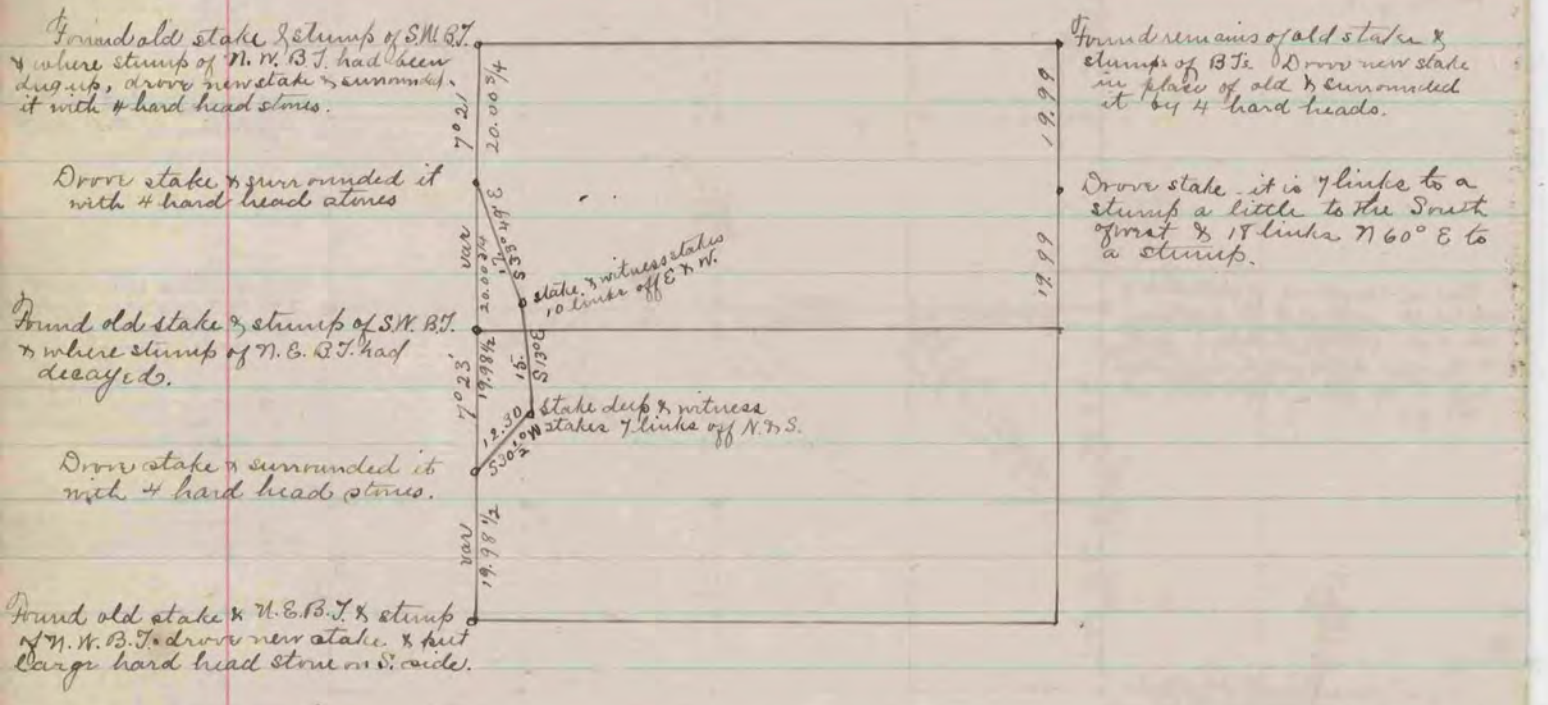

The above is a record & plat of two surveys made on Sec. 16 Johnstown, June 26 & 27, 1871 and July 30, 1877 by Edward Ruger County Surveyor.