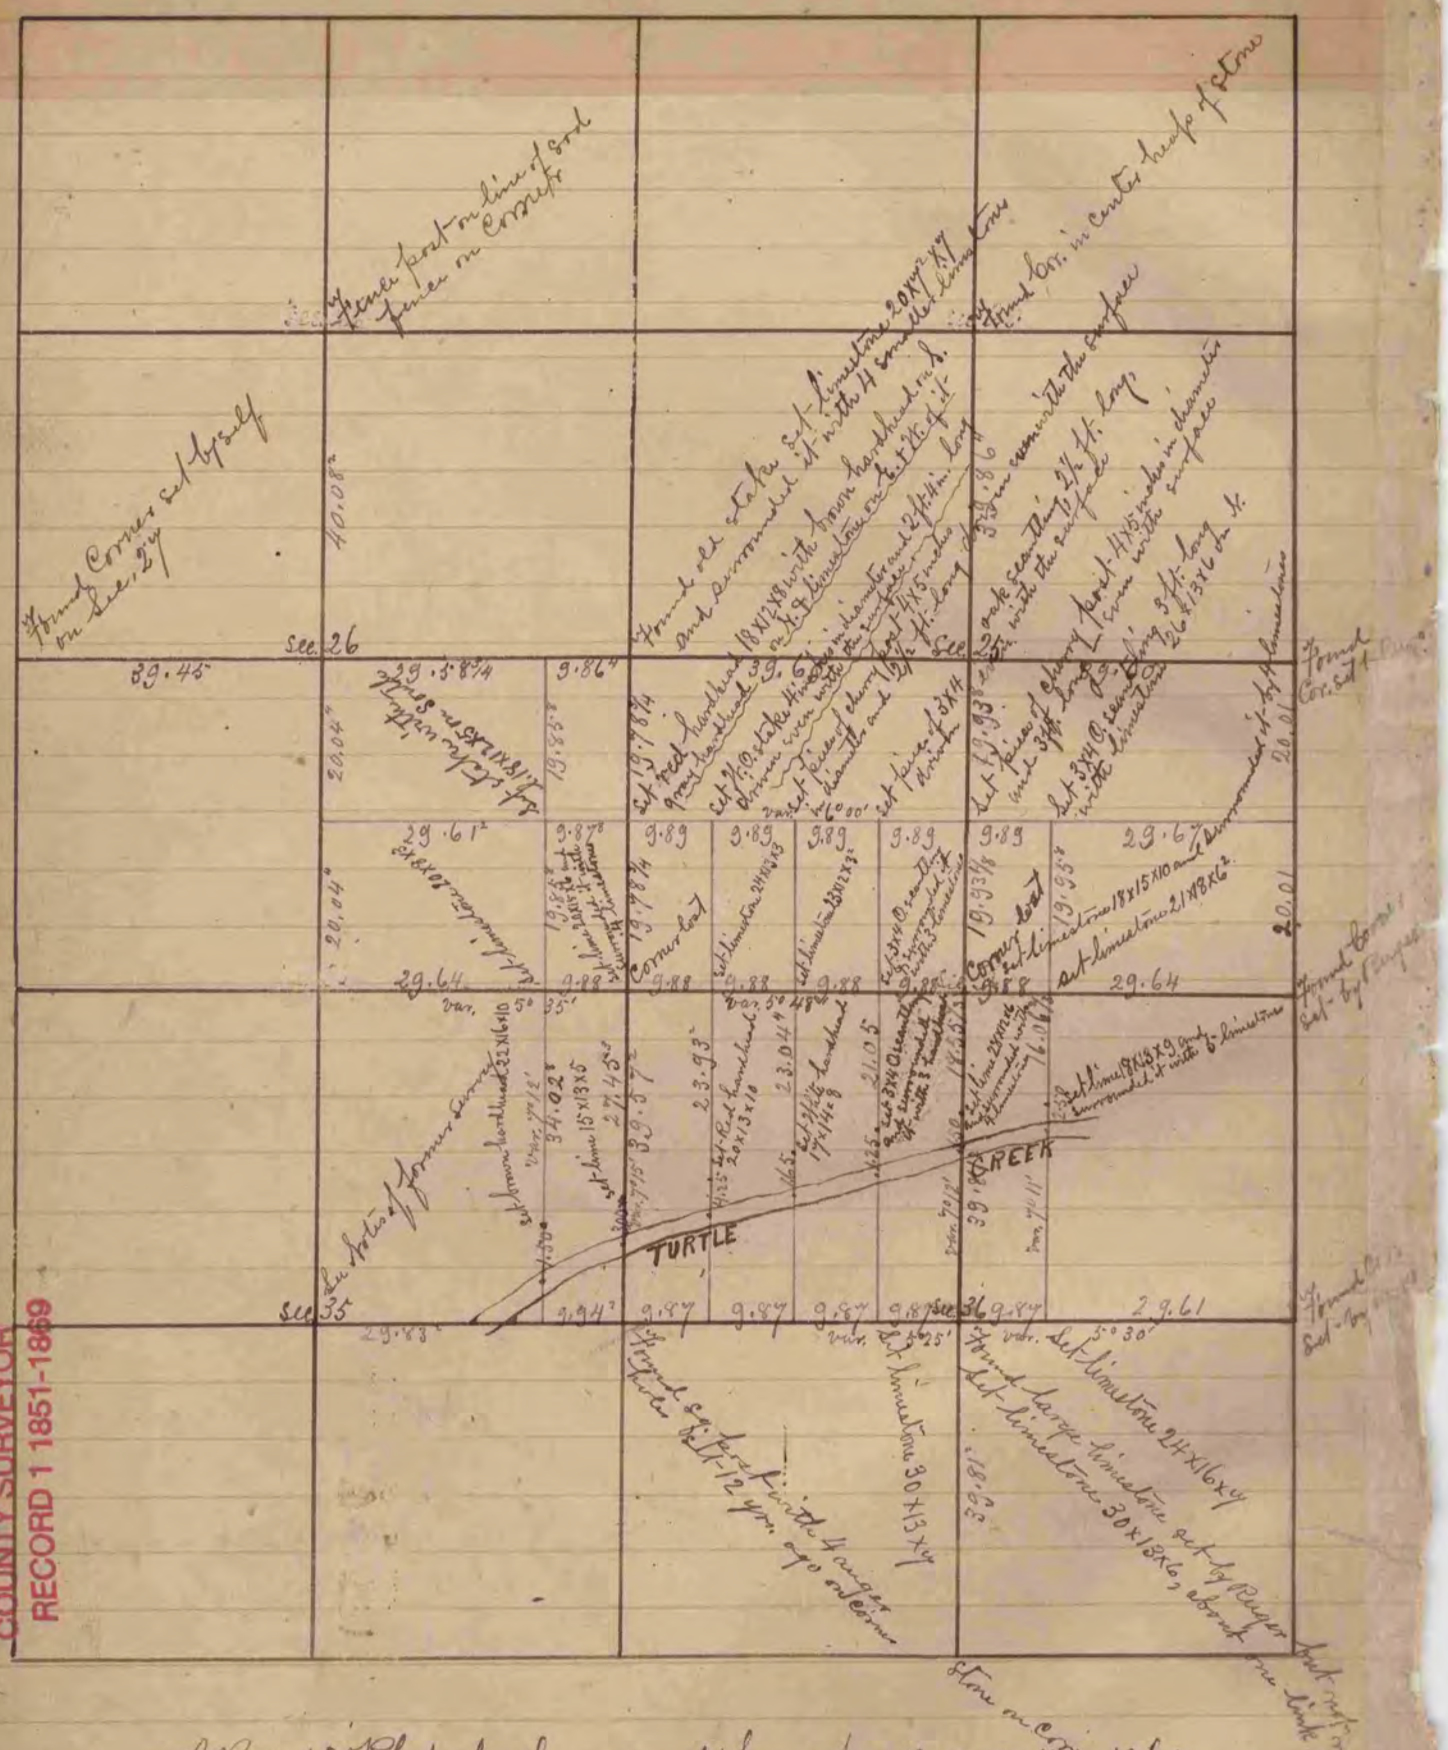

A Record & Plat of a Survey made by me June 12, 13, 15 & 16, 1865,
on Sections 25, 26, 35 & 36, Town of Laprairie

S. D. Locke Co. Surveyor